
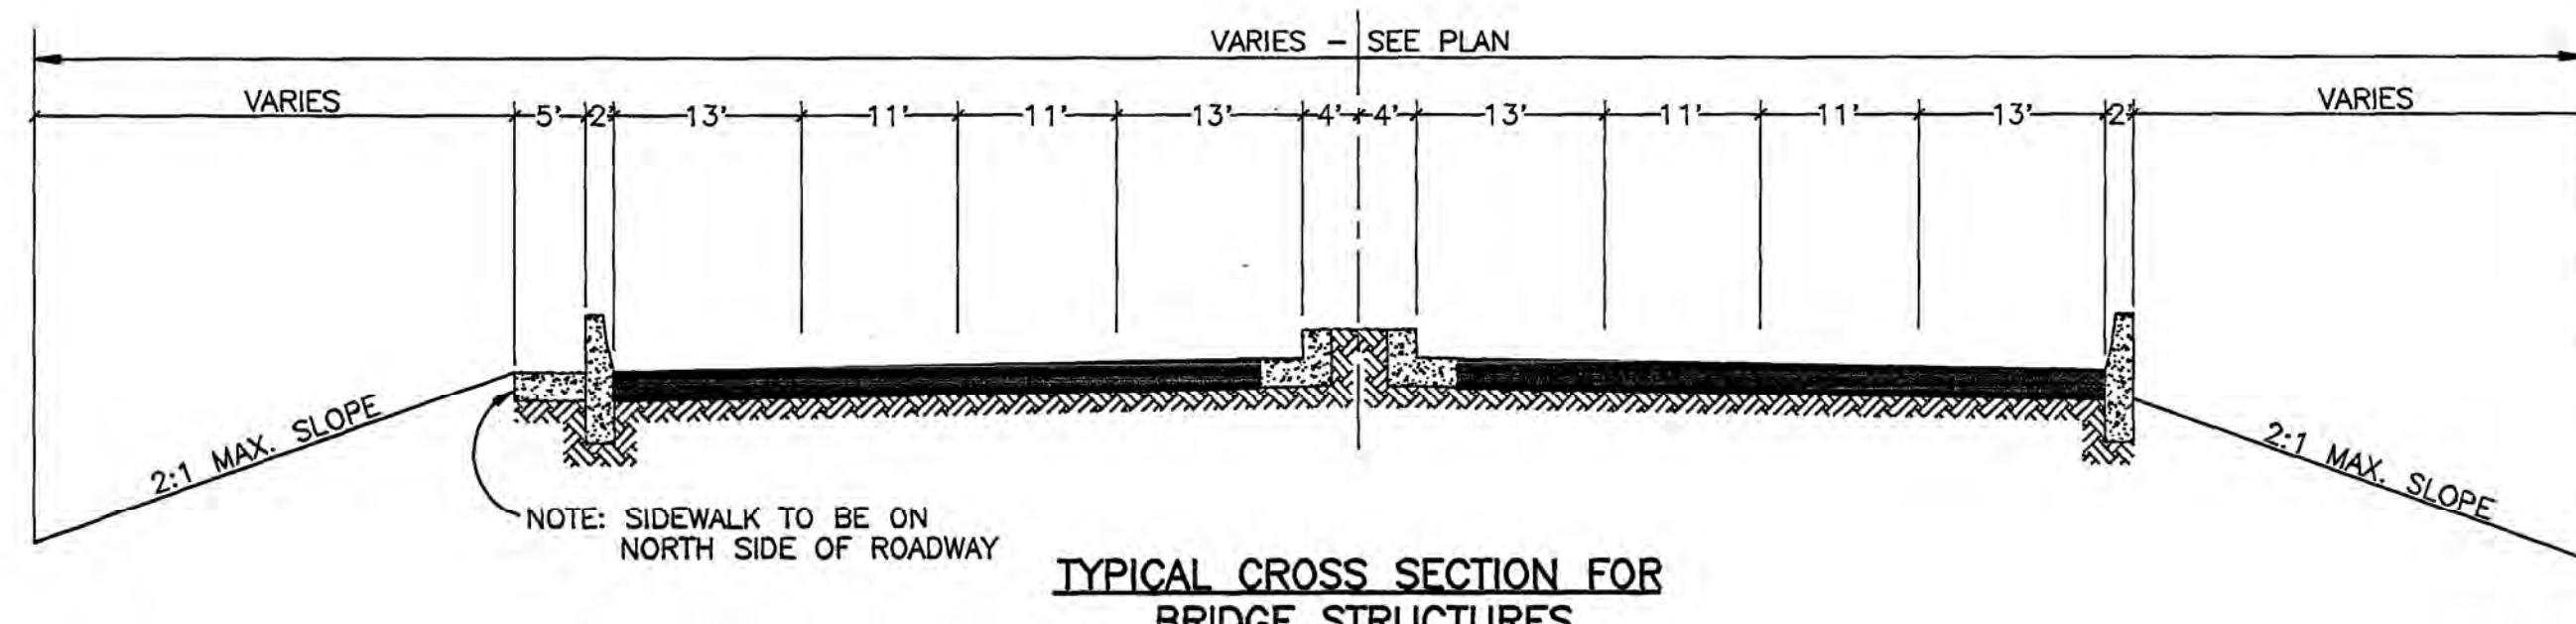




ARCH-AIRPORT/SPERRY ROAD SPECIFIC ROAD PLAN
FROM
INTERSTATE RTE. 5 TO AUSTIN ROAD
CITY OF STOCKTON / SAN JOAQUIN COUNTY, CALIFORNIA

div data-bbox="111 100 458 134" data-label="Section-Header">



TYPICAL CROSS SECTION FOR BRIDGE STRUCTURES

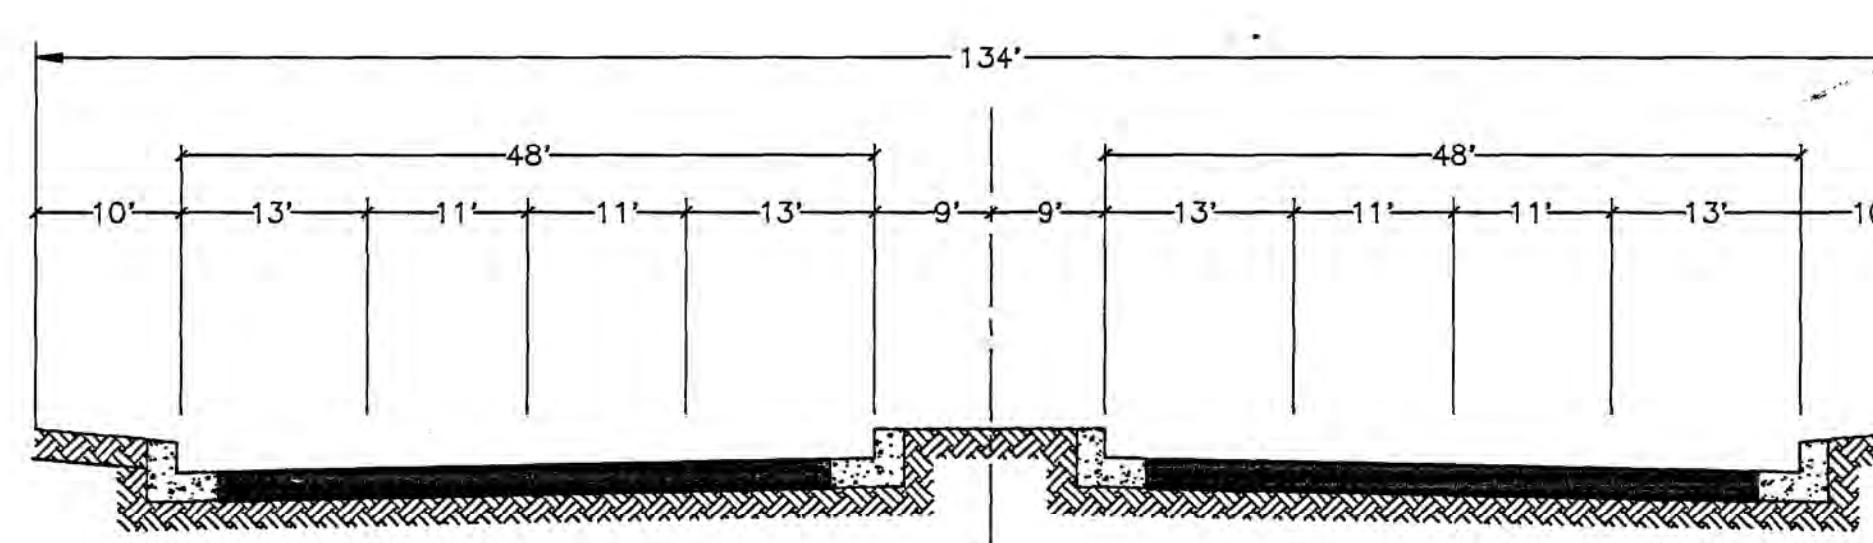

TYPICAL CROSS SECTION FOR STREETS
STA. 0+00 THRU 182+00

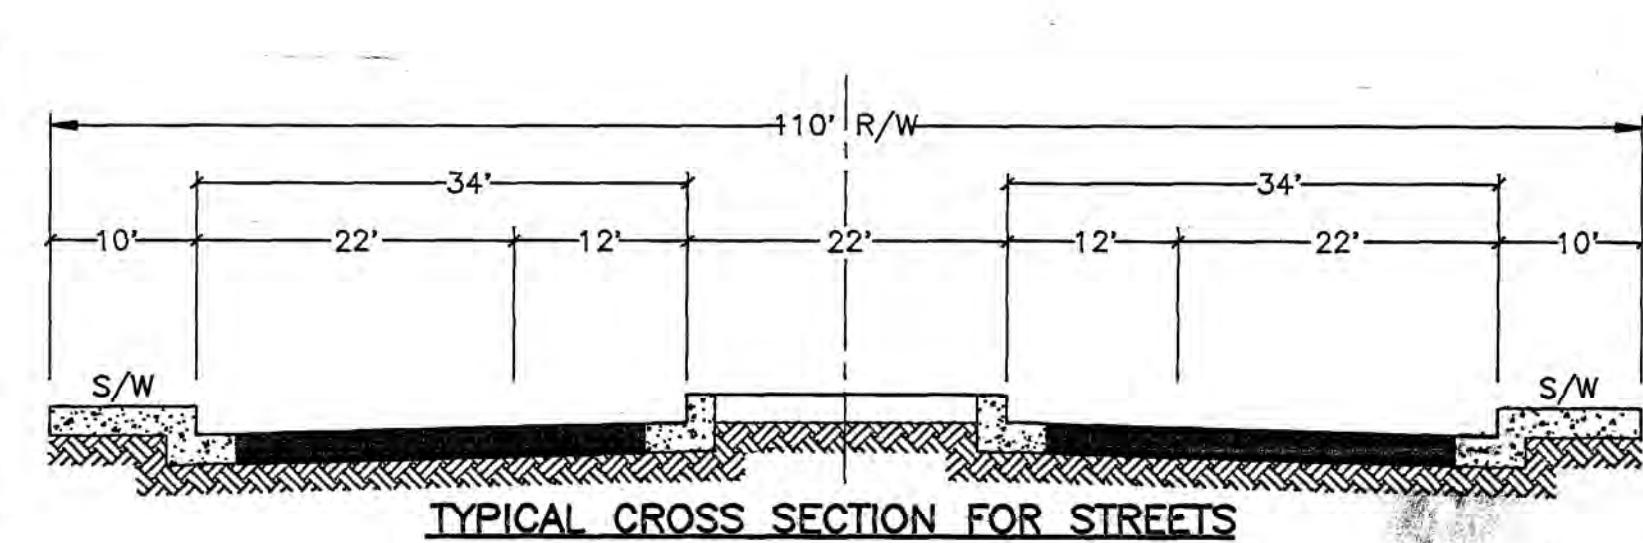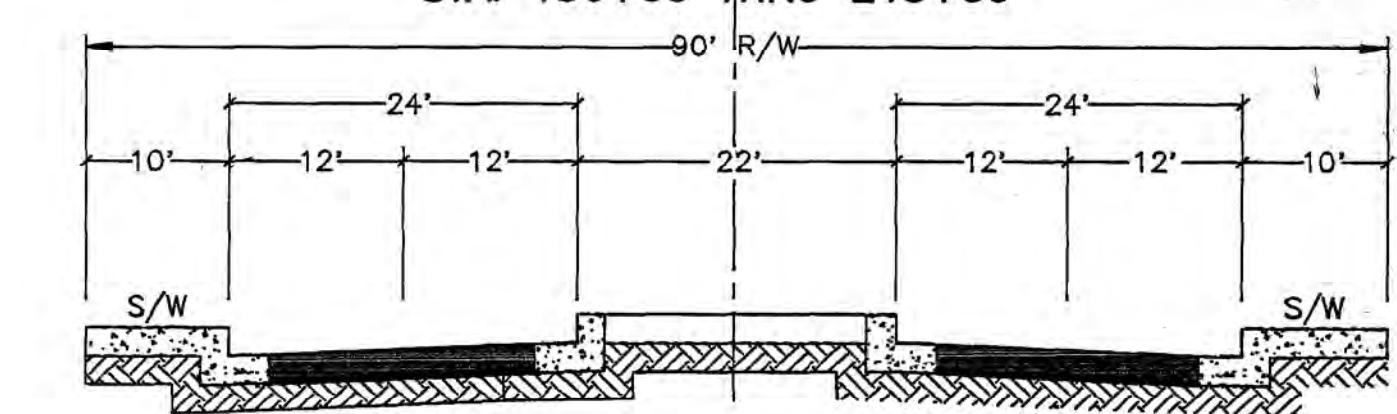STA. 196+00 THRU 218+00

TYPICAL CROSS SECTION FOR STREETS
STA. 222+00 THRU 299+00

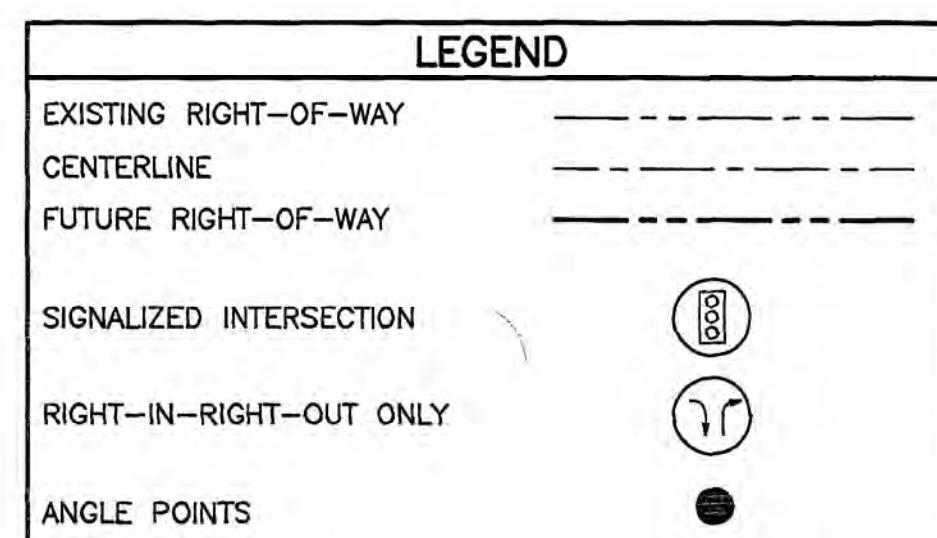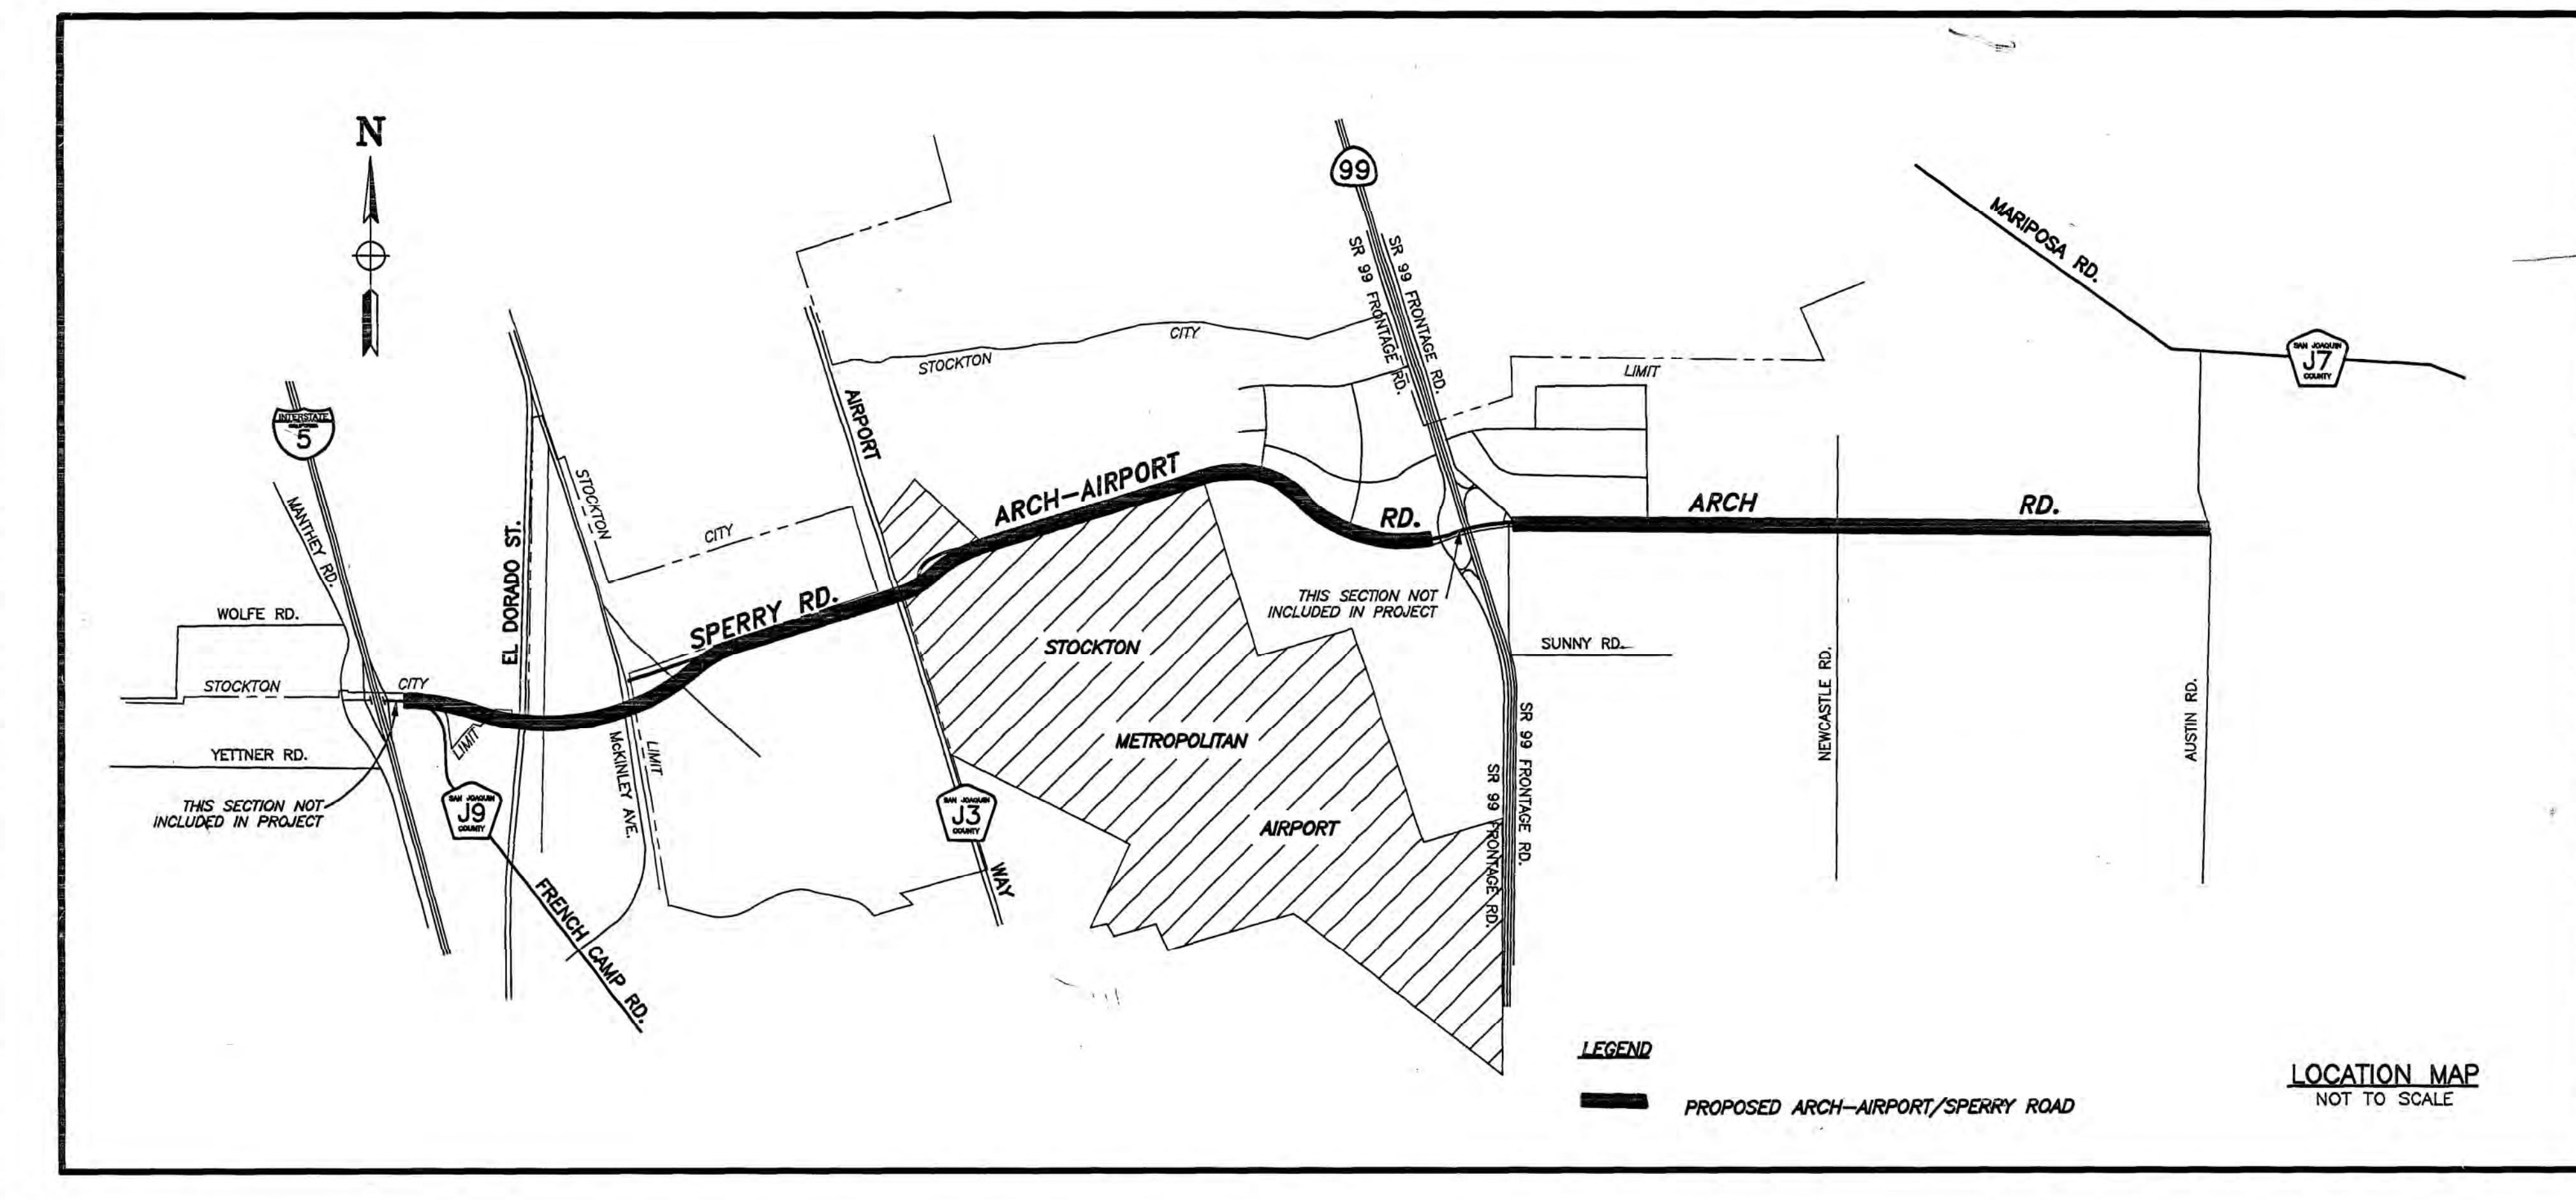

NOTE:
FUTURE ROAD OR ACCESS POINTS ARE APPROXIMATE LOCATION.

RECOMMENDED FOR APPROVAL

THOMAS R. FLINN
DIRECTOR OF PUBLIC WORKS
SAN JOAQUIN COUNTY

RECOMMENDED FOR APPROVAL

Christopher Eley

CHRISTOPHER ELEY, CHAIR
SAN JOAQUIN COUNTY
PLANNING COMMISSION

APPROVED Victor Mow 2/10/02
VICTOR MOW, CHAIR
SAN JOAQUIN COUNTY
BOARD OF SUPERVISORS
DATE




ARCH-AIRPORT/SPERRY ROAD


GEOMETRIC PLAN LINE

DEPARTMENT OF PUBLIC WORKS
CITY OF STOCKTON, CALIFORNIA

4604C

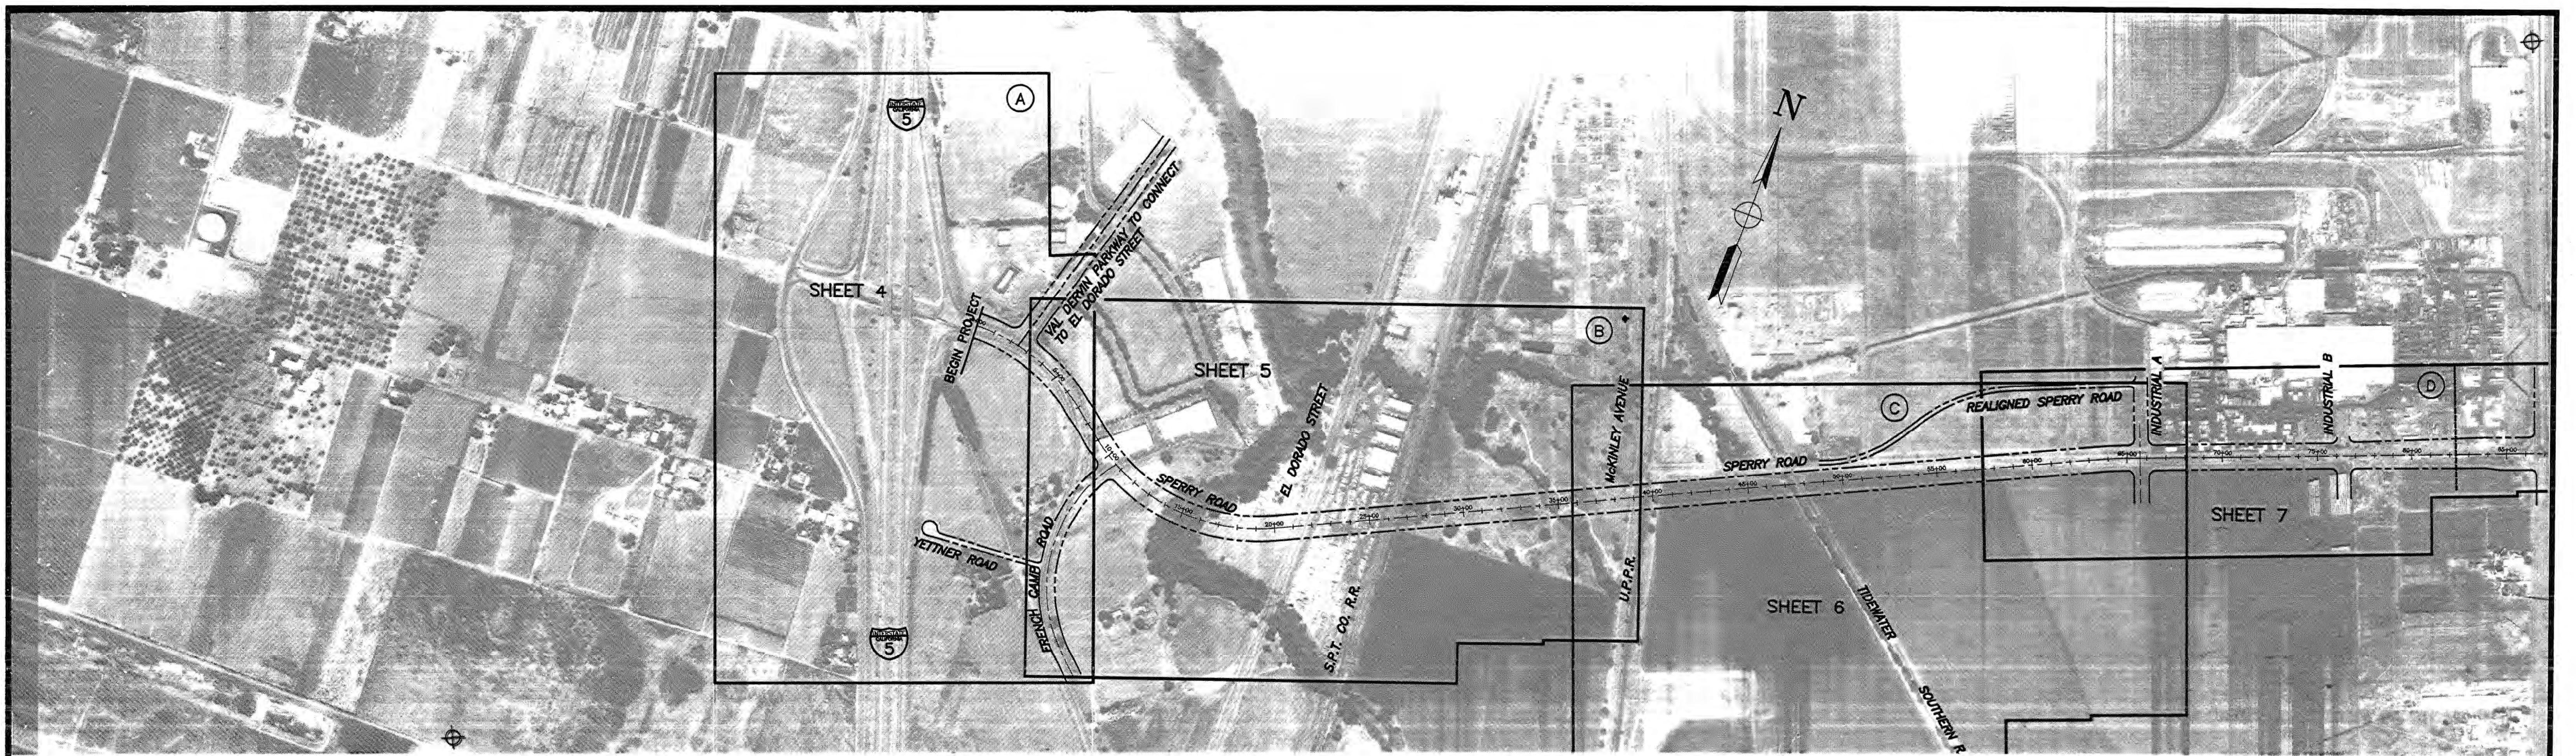

4604.1C
ARCH-AIRPORT/SPERRY ROAD
SPECIFIC ROAD PLAN
FROM INTERSTATE FIVE TO AUSTIN ROAD
GEOMETRIC PLAN LINE
TJN TRANSPORTATION CONSULTANTS
AUGUST 23, 2002

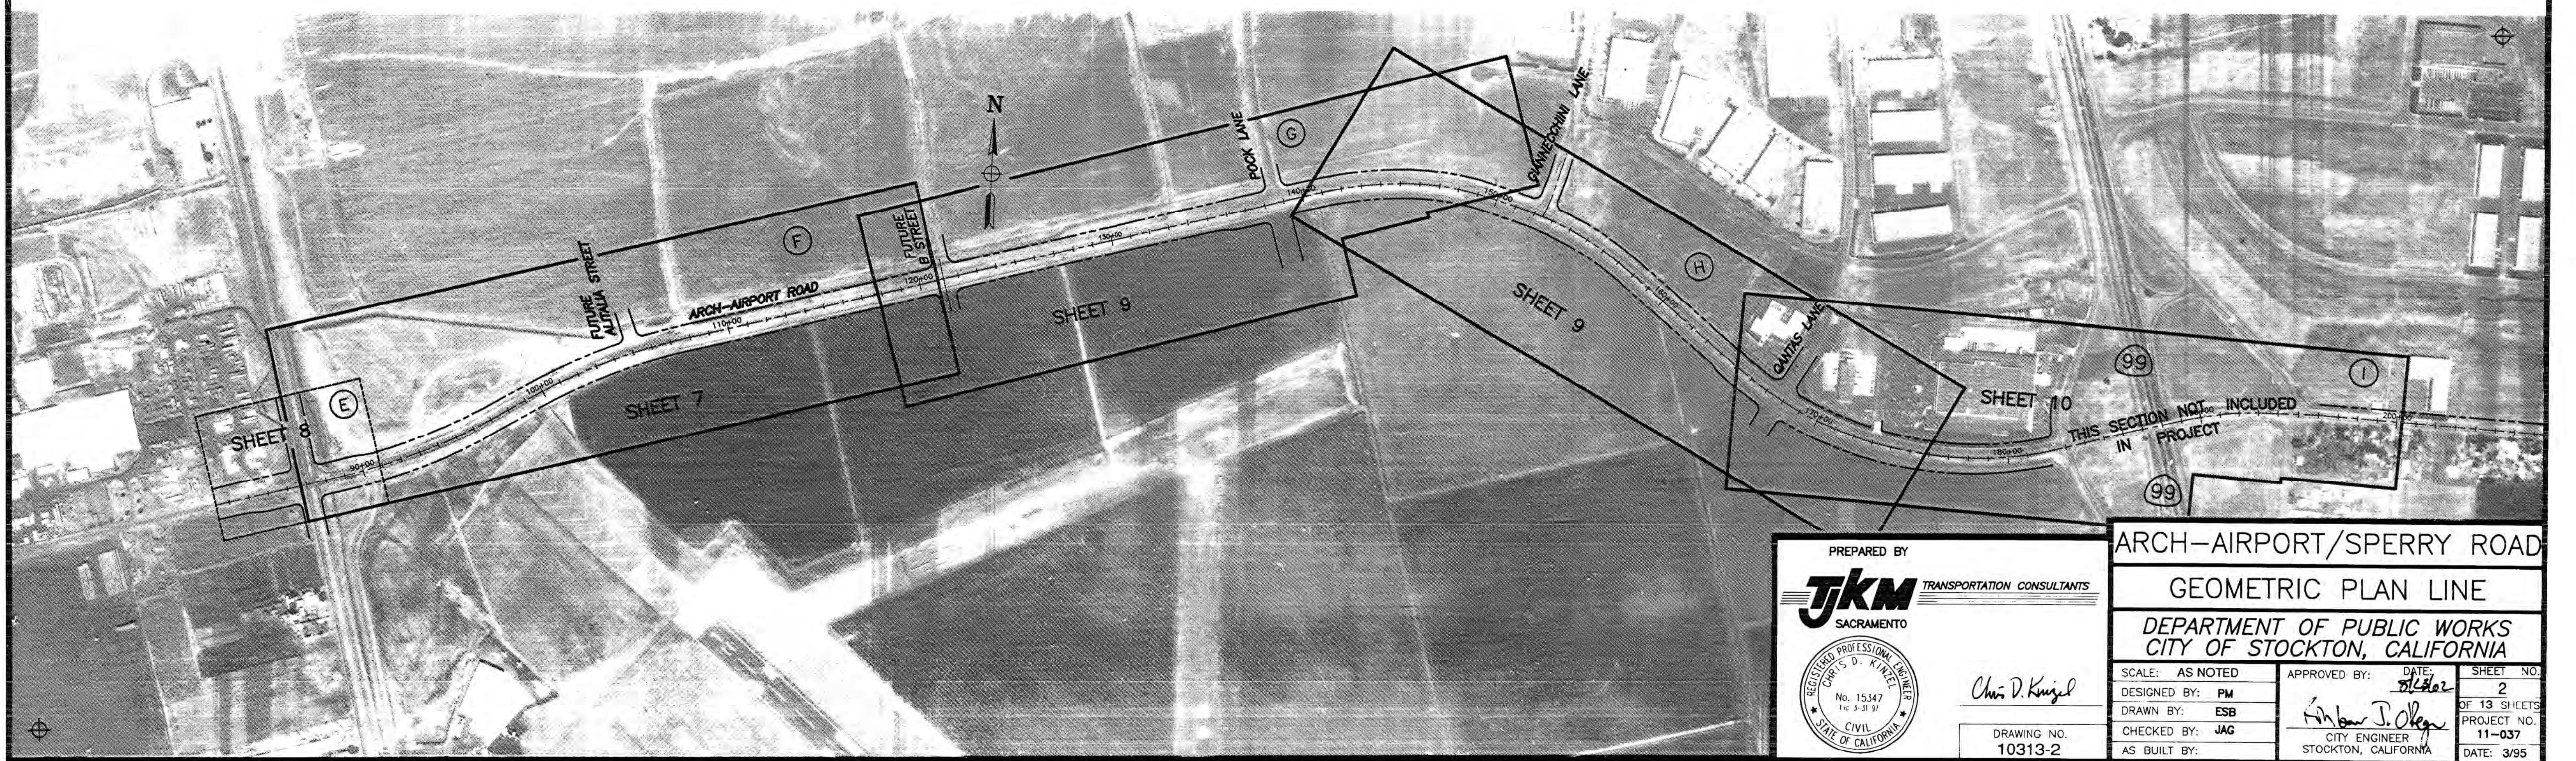

PREPARED BY
JKM TRANSPORTATION CONSULTANTS
SACRAMENTO
REGISTERED PROFESSIONAL ENGINEER
CIVIL
STATE OF CALIFORNIA
No. 15347
Exp. 3-31-97
Chris D. Kujel

DEPARTMENT OF PUBLIC WORKS
CITY OF STOCKTON, CALIFORNIA
SCALE: AS NOTED
DESIGNED BY: PM
DRAWN BY: ESB
CHECKED BY: JAG
AS BUILT BY: *Kimber J. O'Leary*
APPROVED BY: *John J. O'Leary*
DATE: 8/25/02
SHEET NO. 2
OF 13 SHEETS
PROJECT NO. 11-037
DRAWING NO. 10313-2
CITY ENGINEER
STOCKTON, CALIFORNIA
DATE: 3/95


4604.1C




4604.2C
ARCH-AIRPORT/SPERRY ROAD
SPECIFIC ROAD PLAN
FROM INTERSTATE FIVE TO AUSTIN ROAD
GEOMETRIC PLAN LINE
JKM TRANSPORTATION CONSULTANTS
AUGUST 23, 2002

ARCH-AIRPORT/SPERRY ROAD		
GEOMETRIC PLAN LINE		
DEPARTMENT OF PUBLIC WORKS CITY OF STOCKTON, CALIFORNIA		
SCALE: AS NOTED DESIGNED BY: PM DRAWN BY: ESB CHECKED BY: JAG AS BUILT BY:	APPROVED BY: <i>John D. King</i> CITY ENGINEER STOCKTON, CALIFORNIA	DATE: 8/28/02 SHEET NO. 3 OF 13 SHEETS PROJECT NO. 11-037 DATE: 3/95
DRAWING NO. 10313-3		

4604.2C

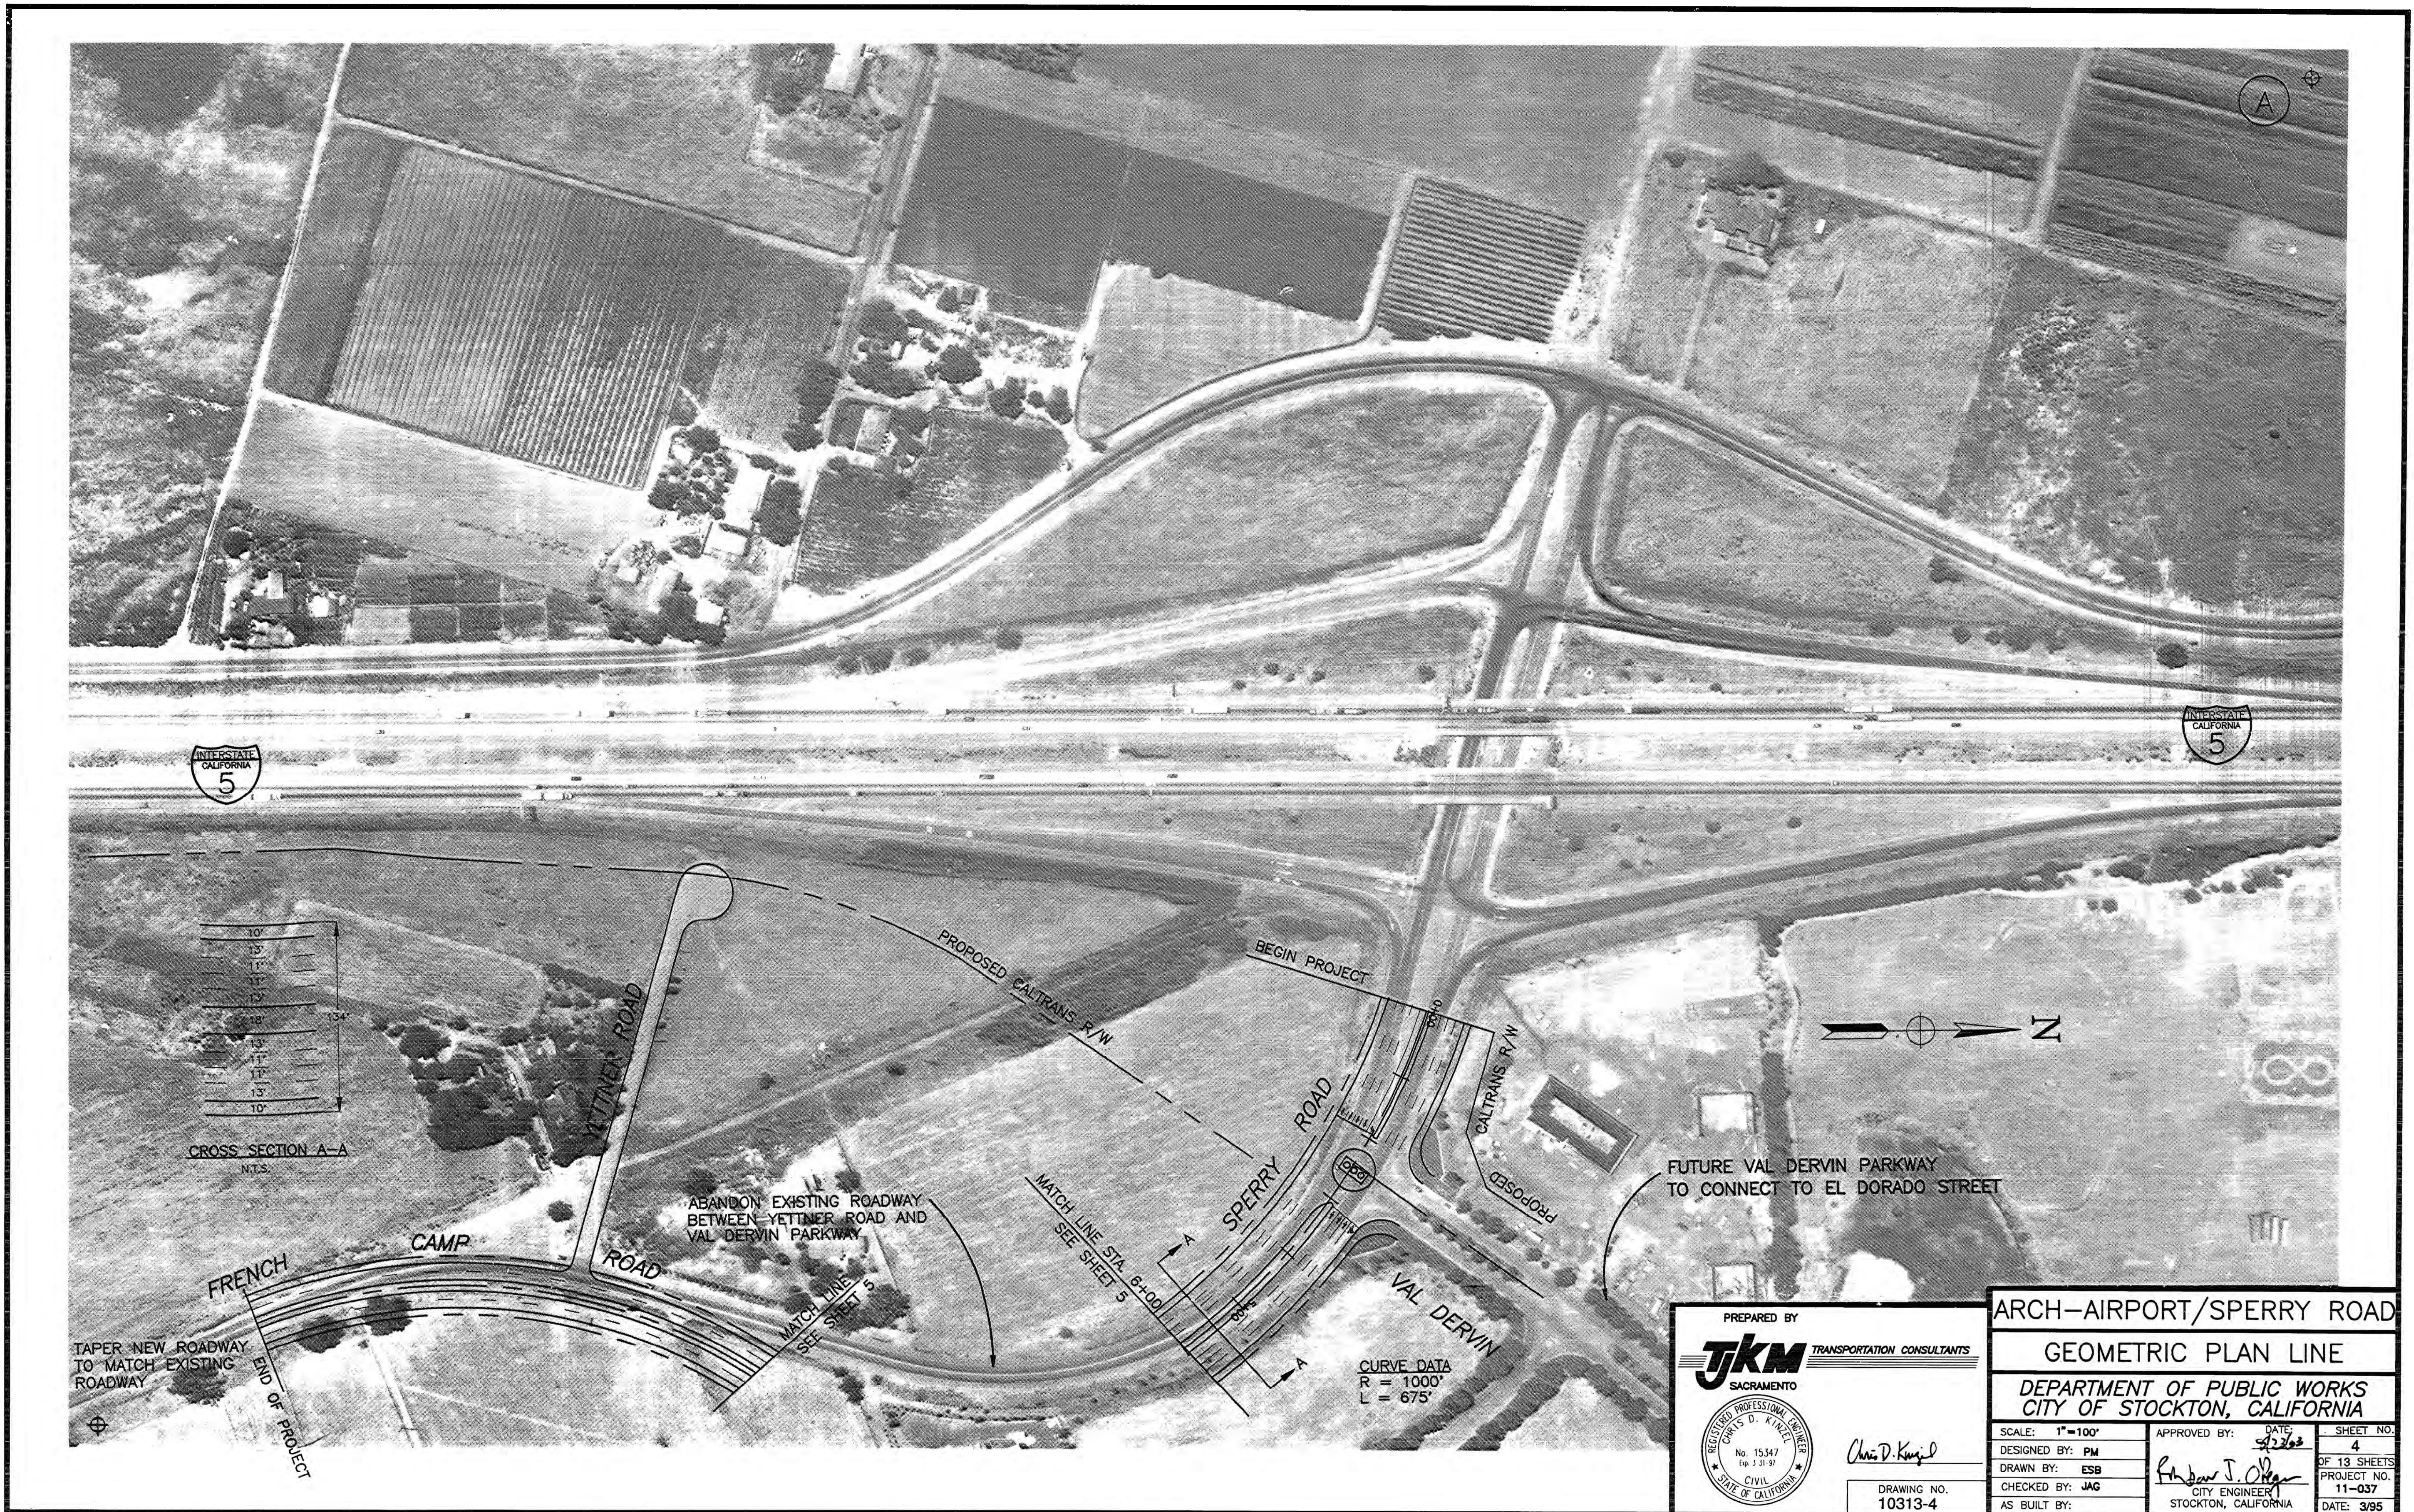



4604.3C

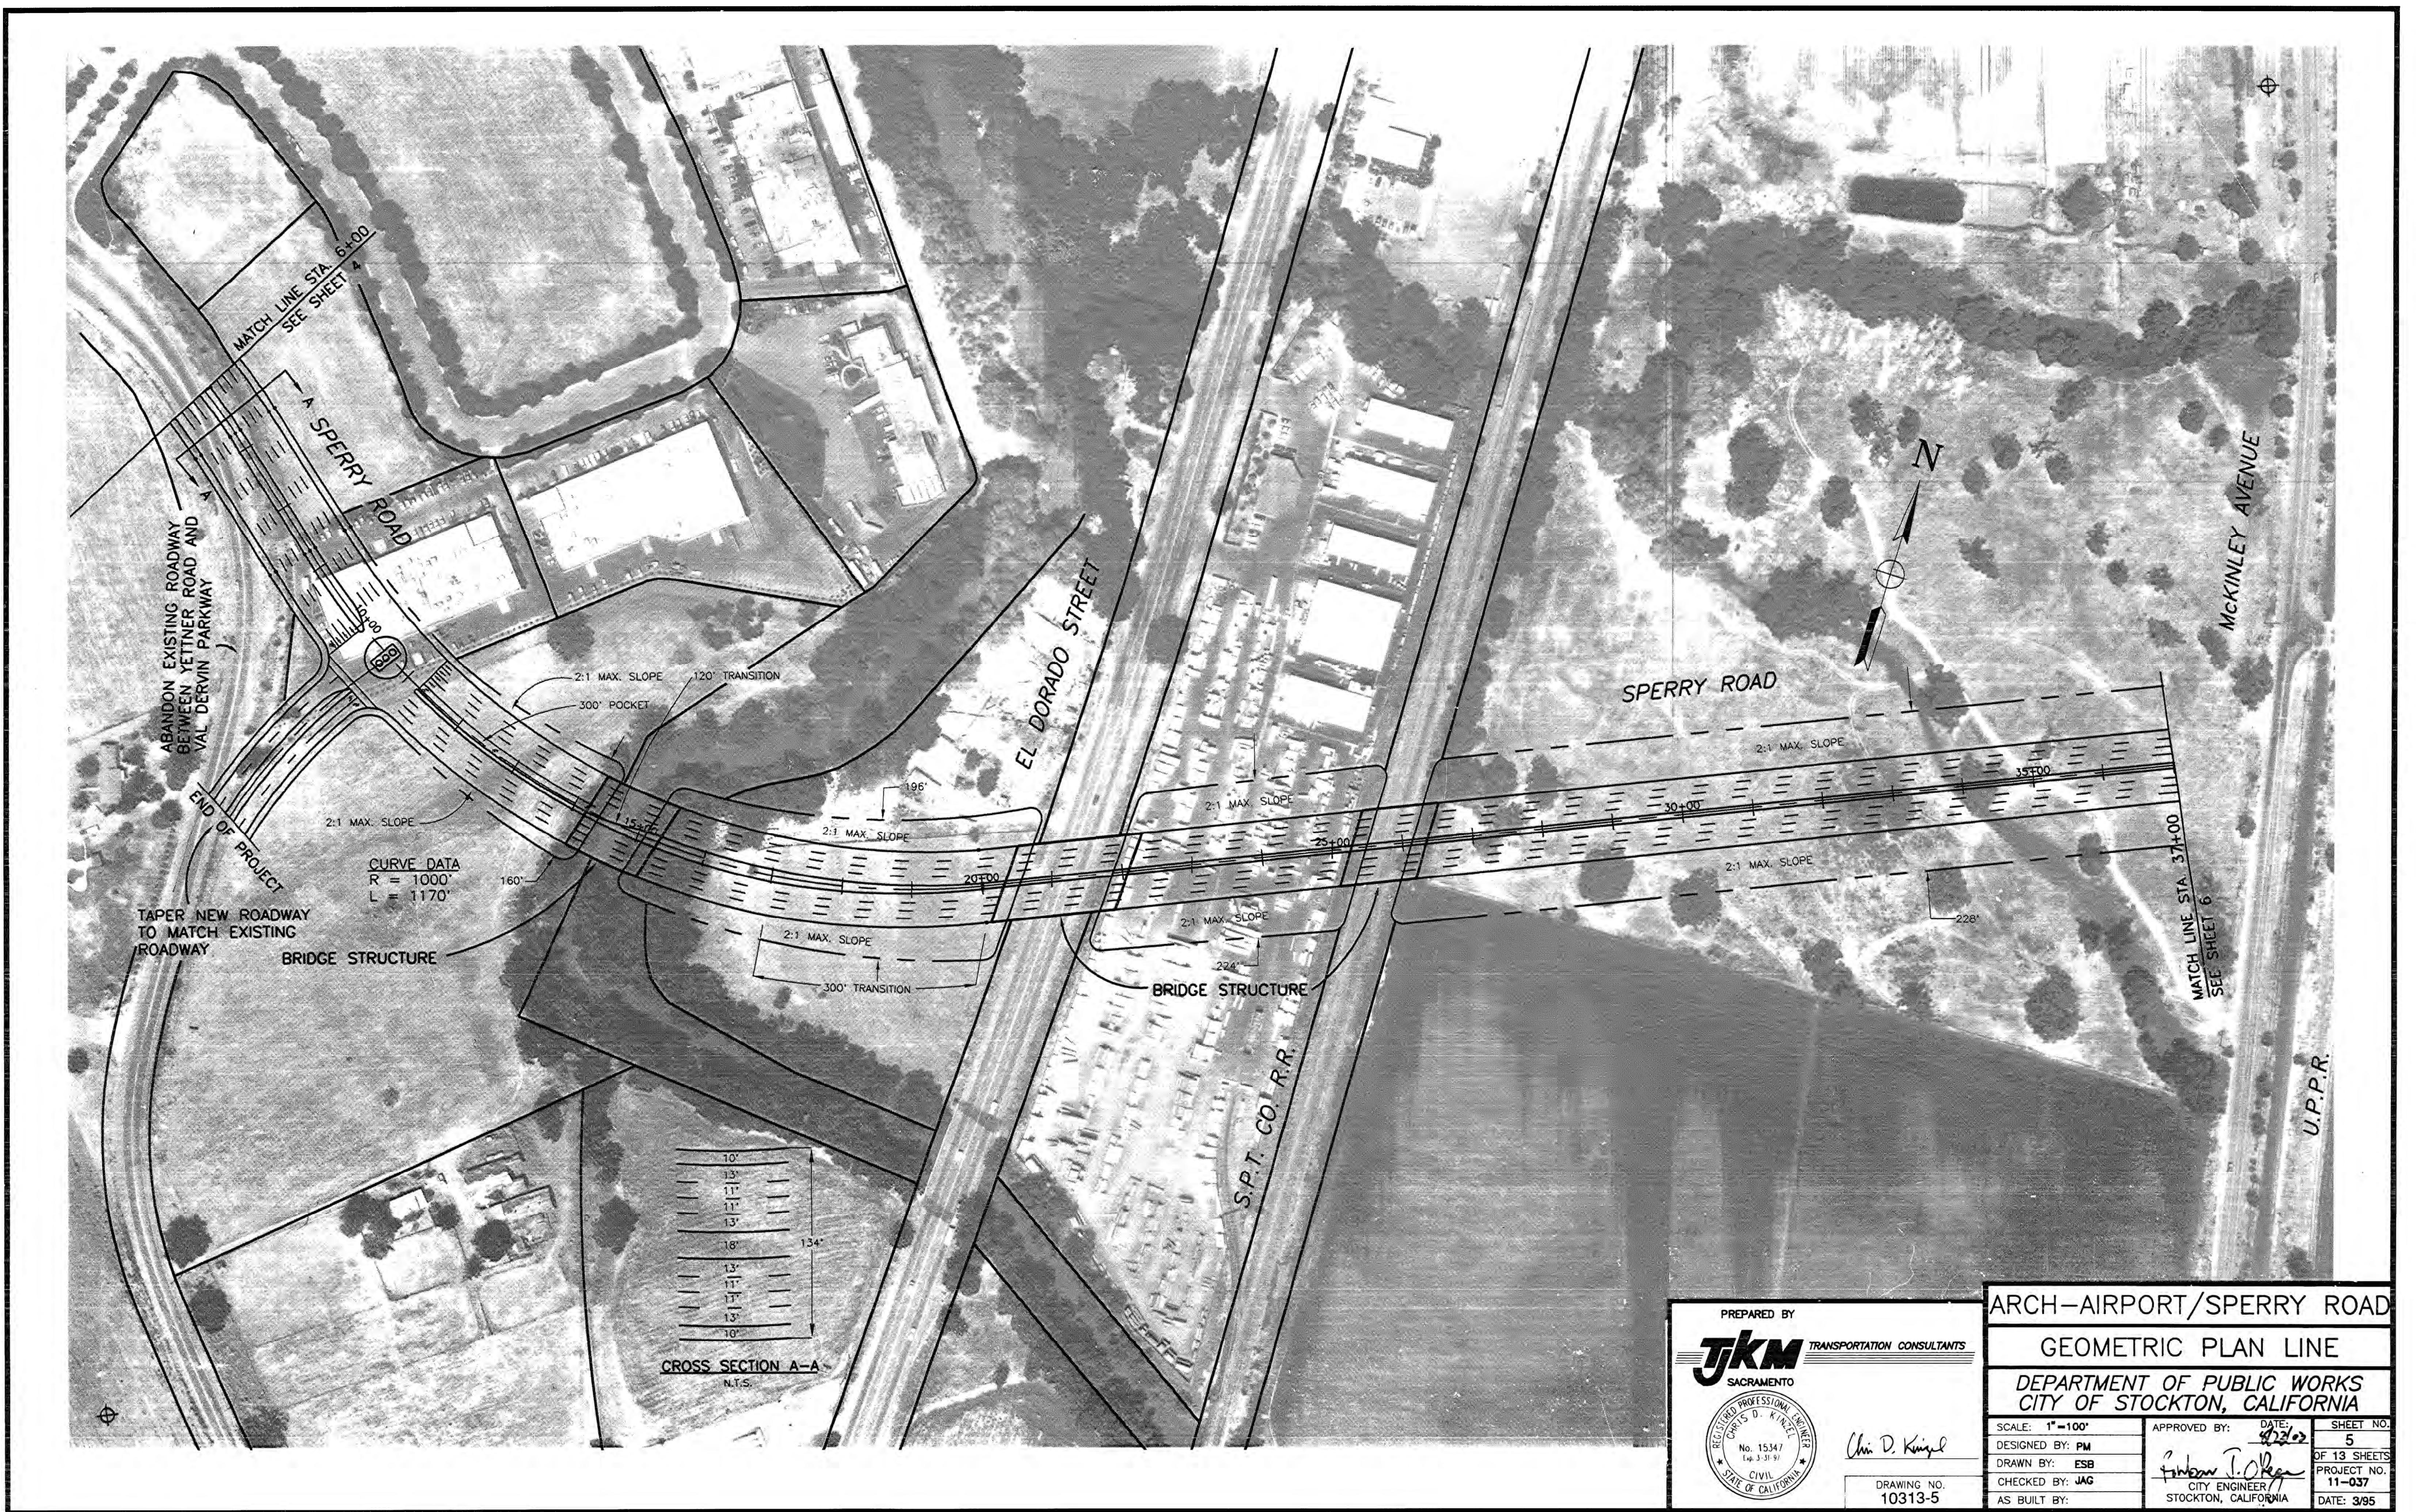



4604.4C




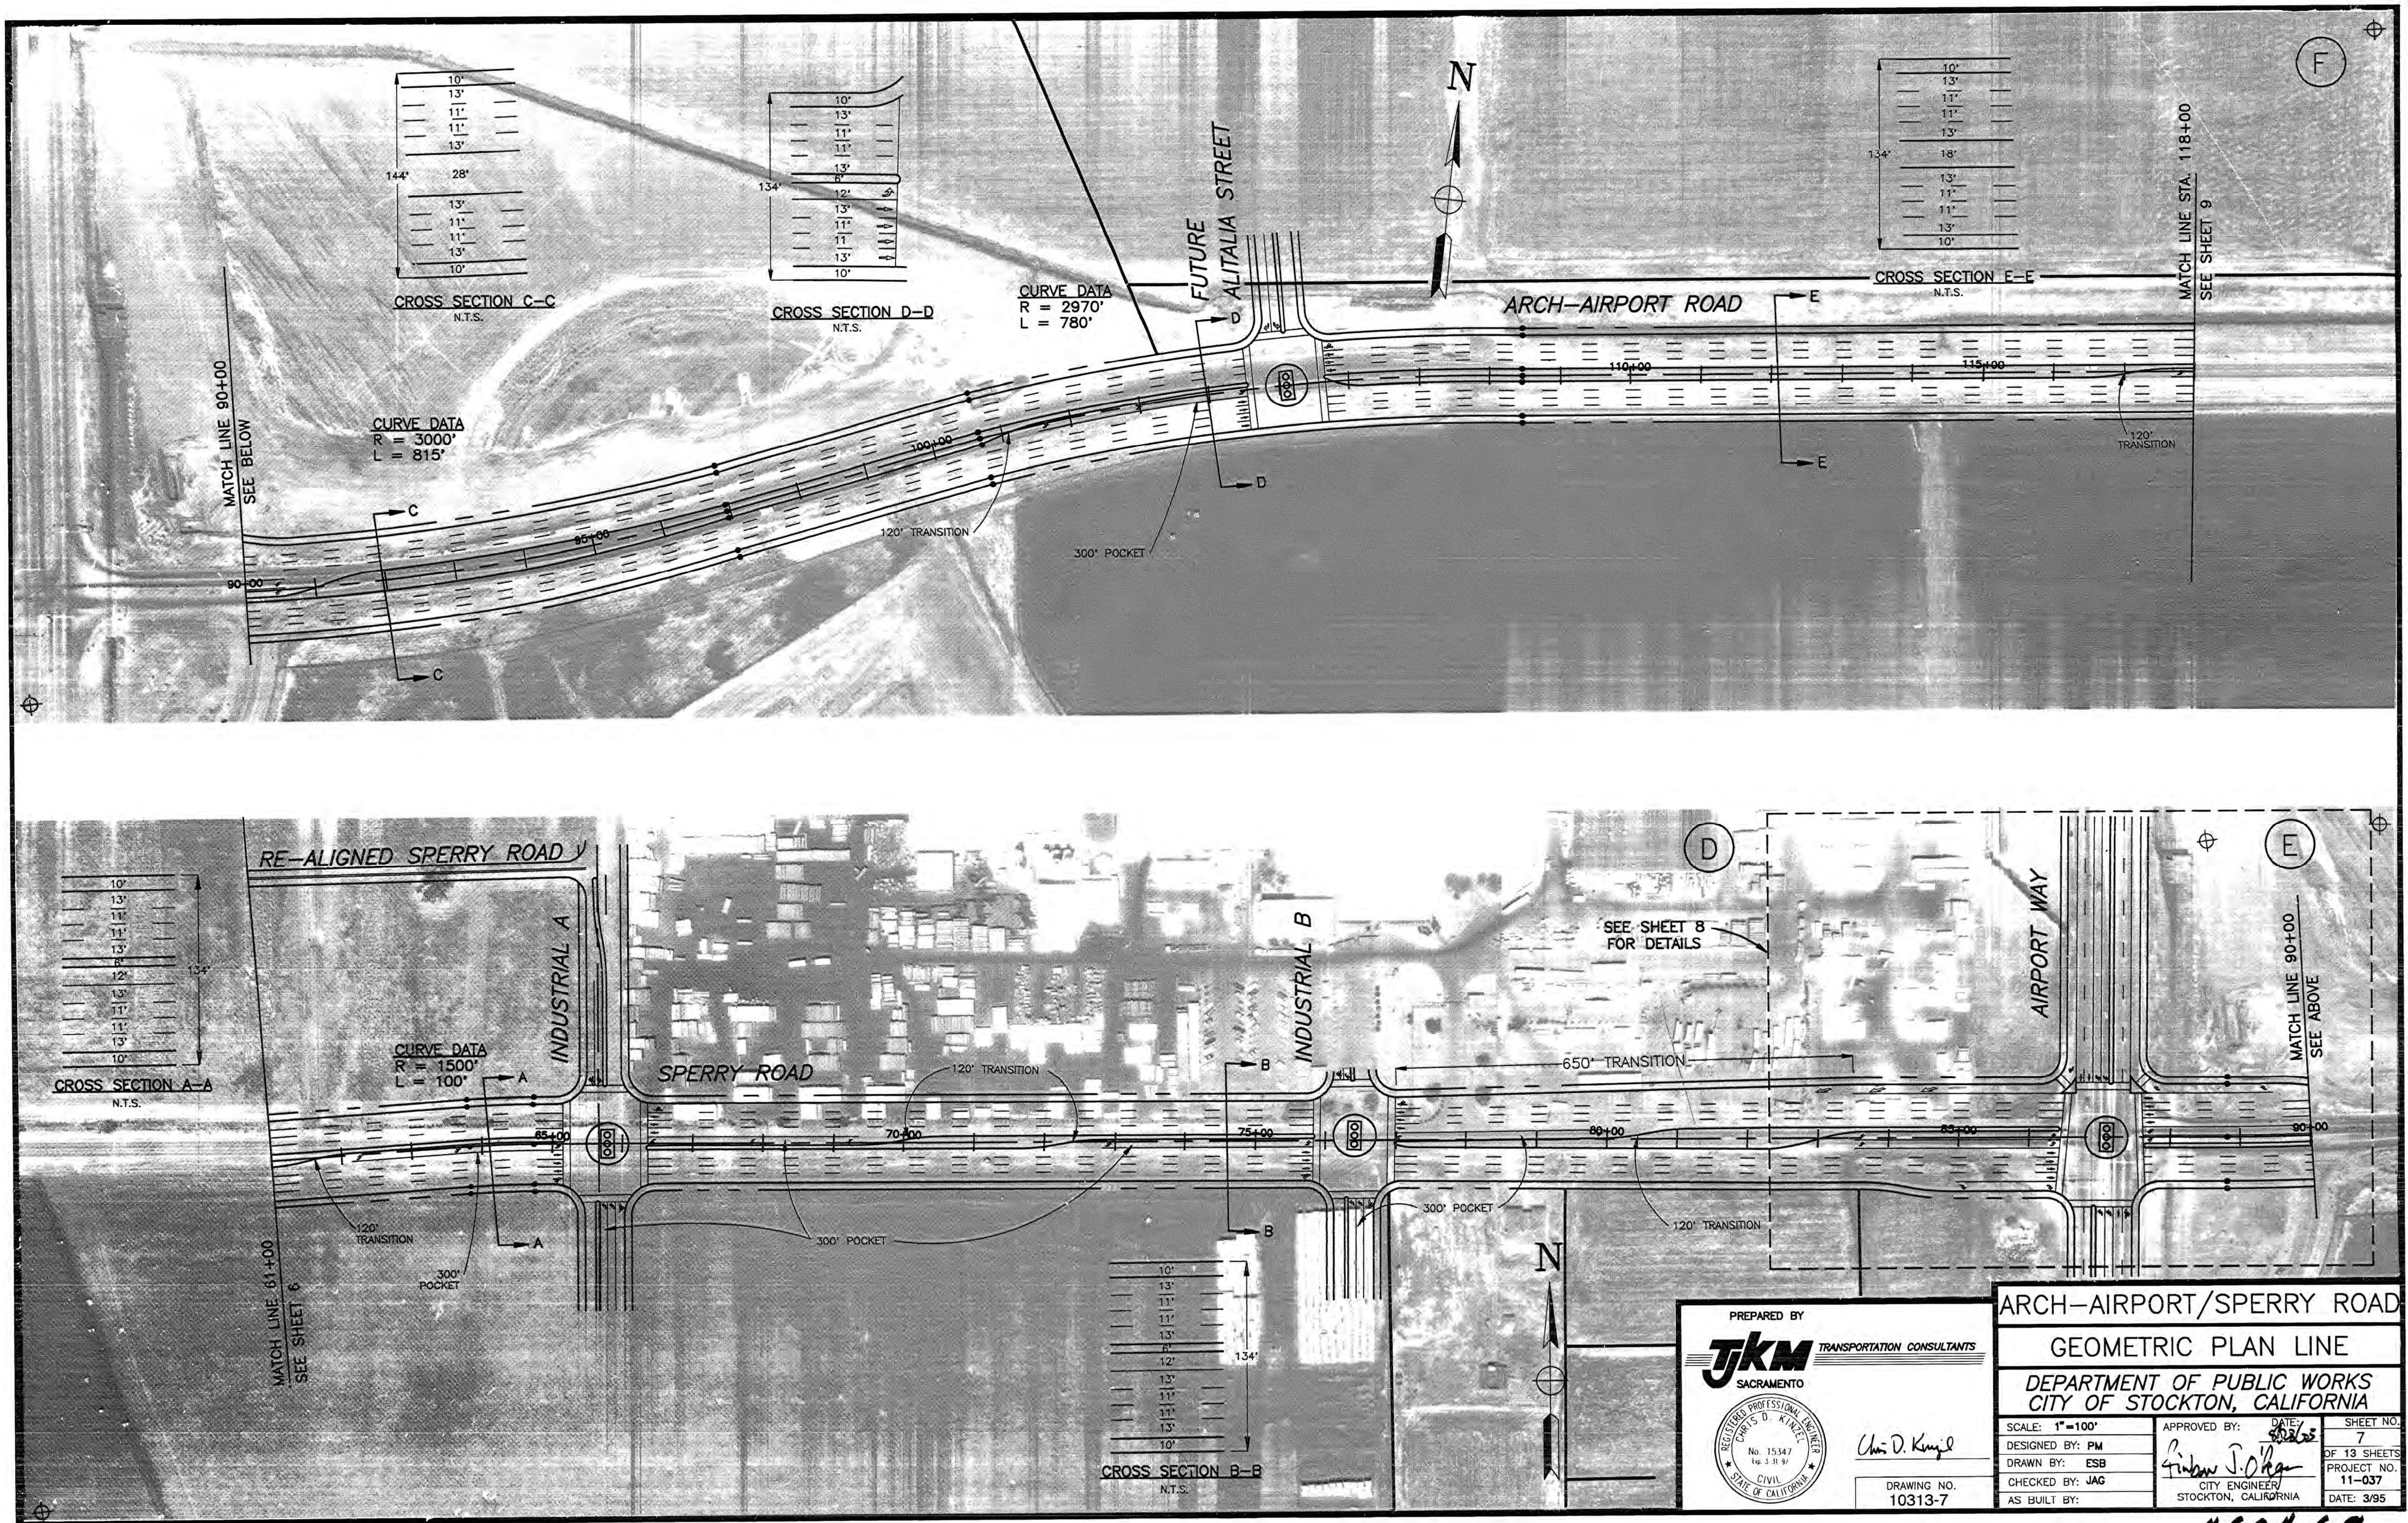


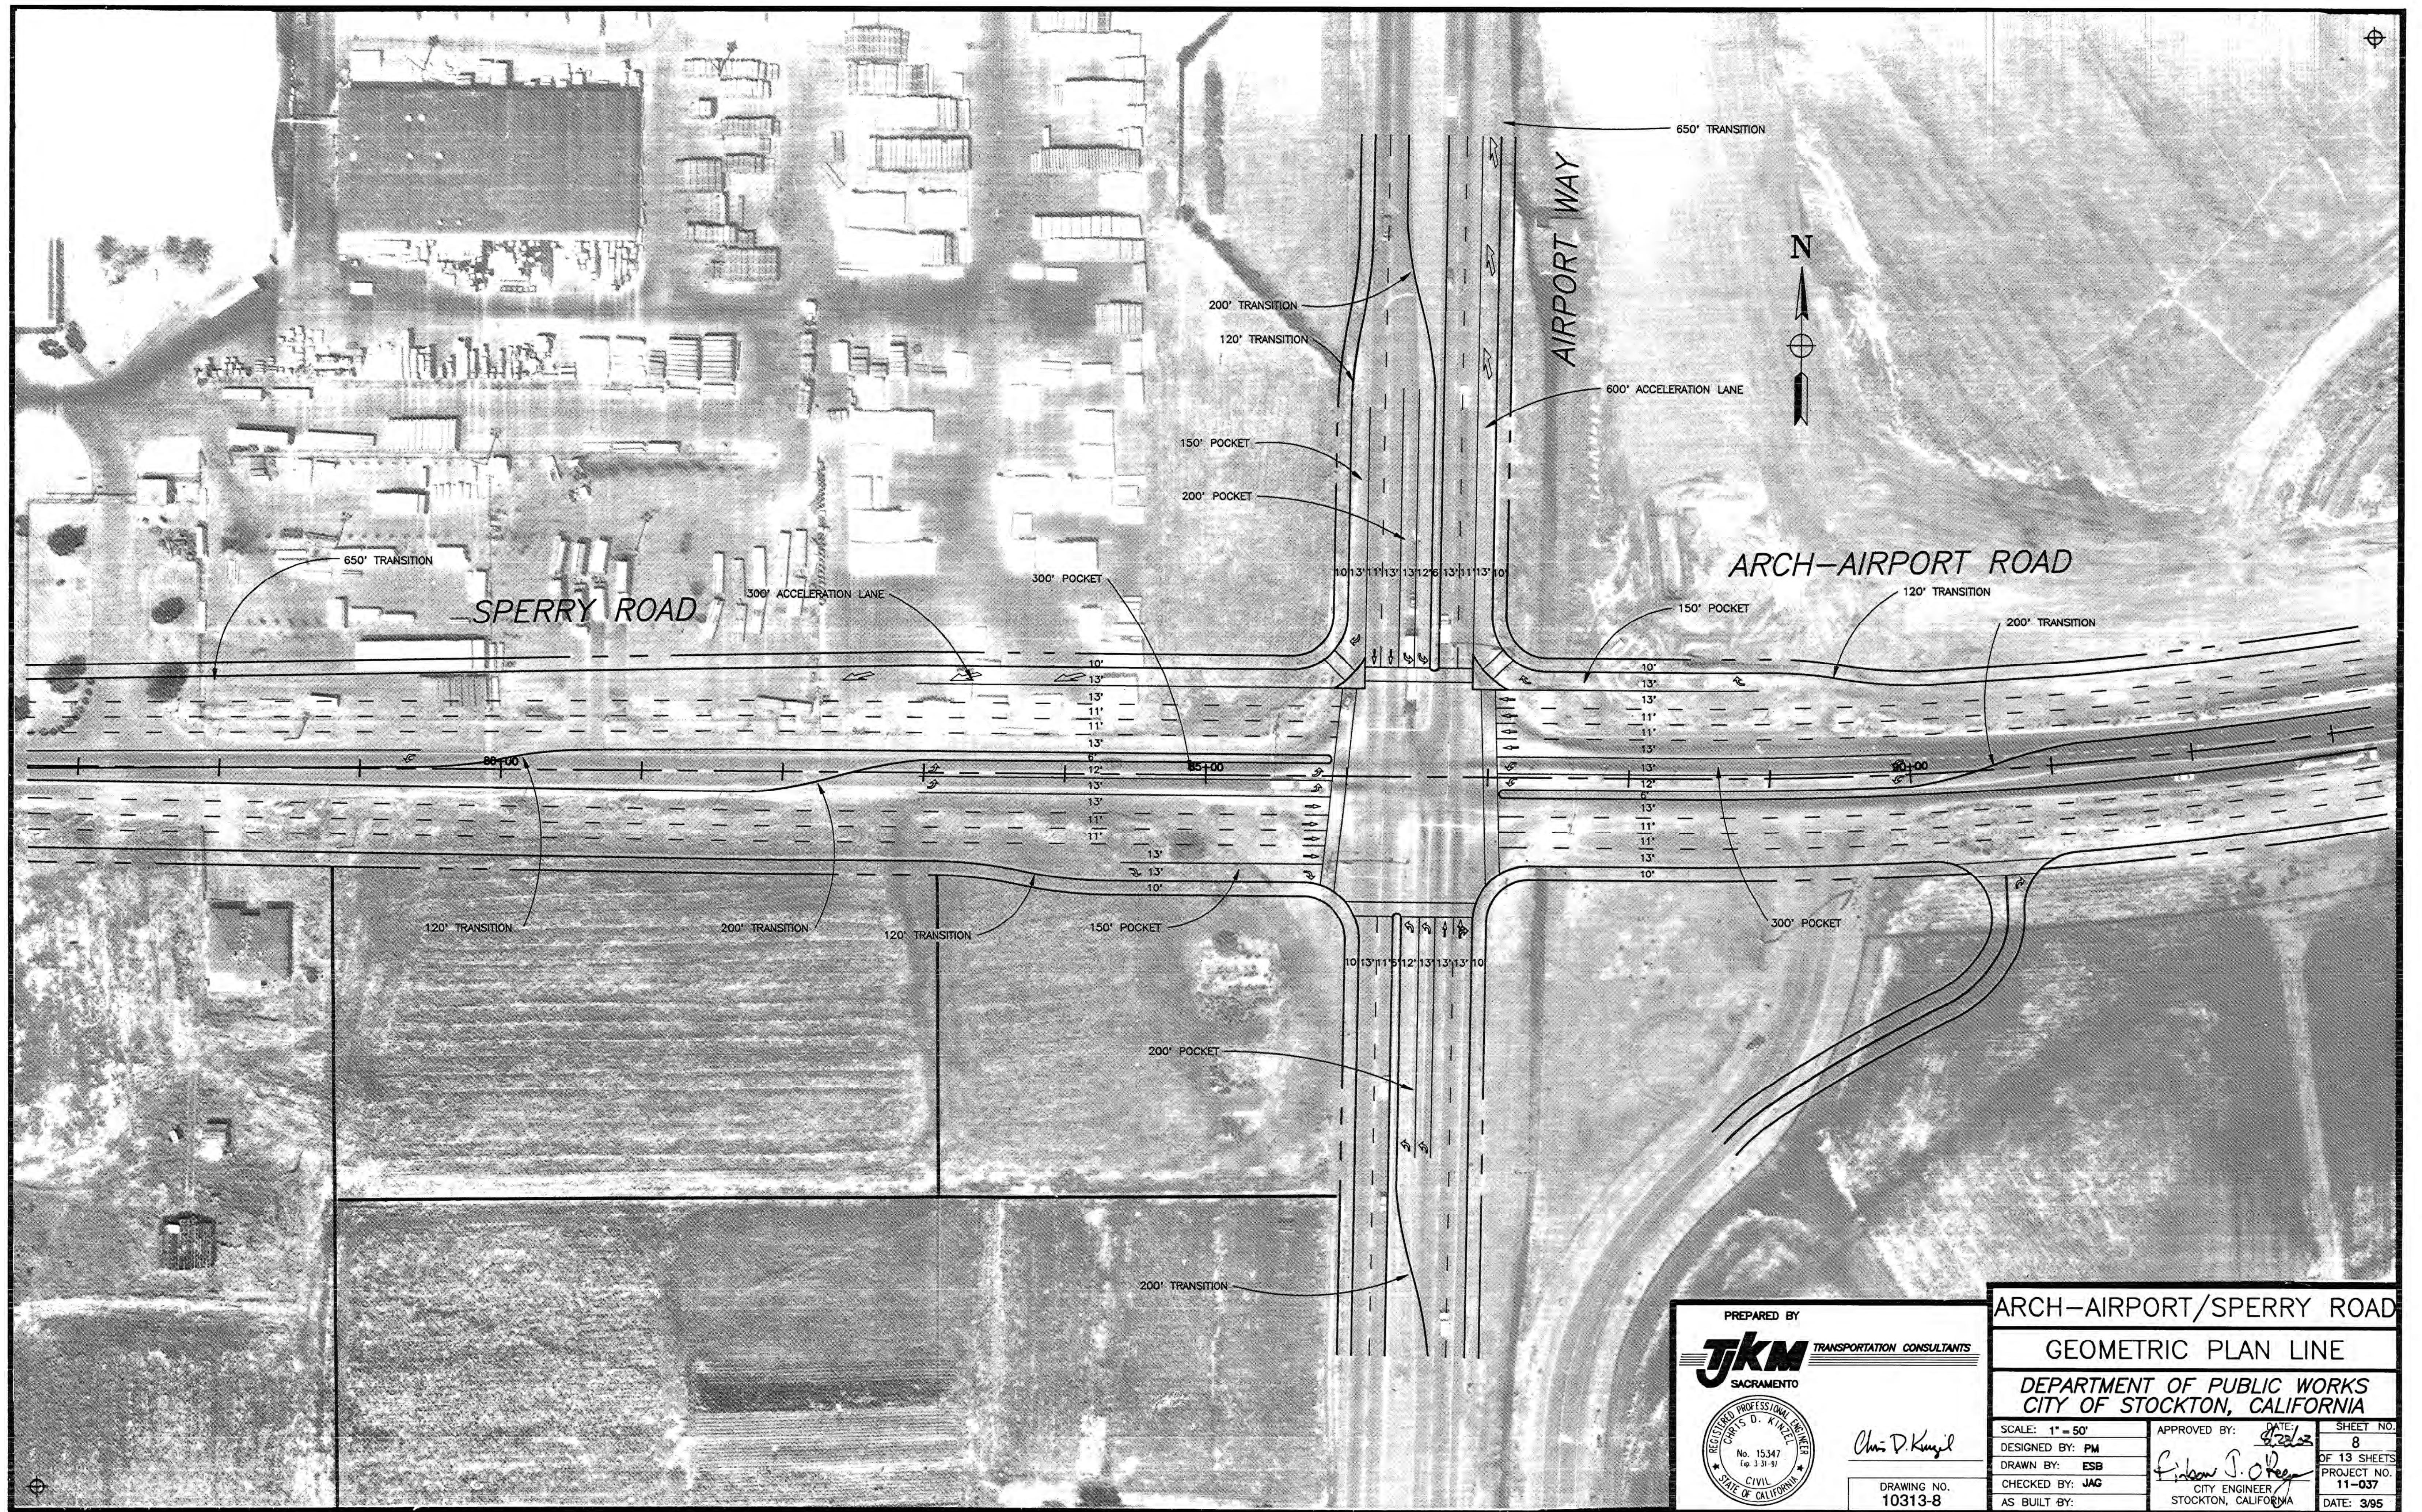


4604.7C

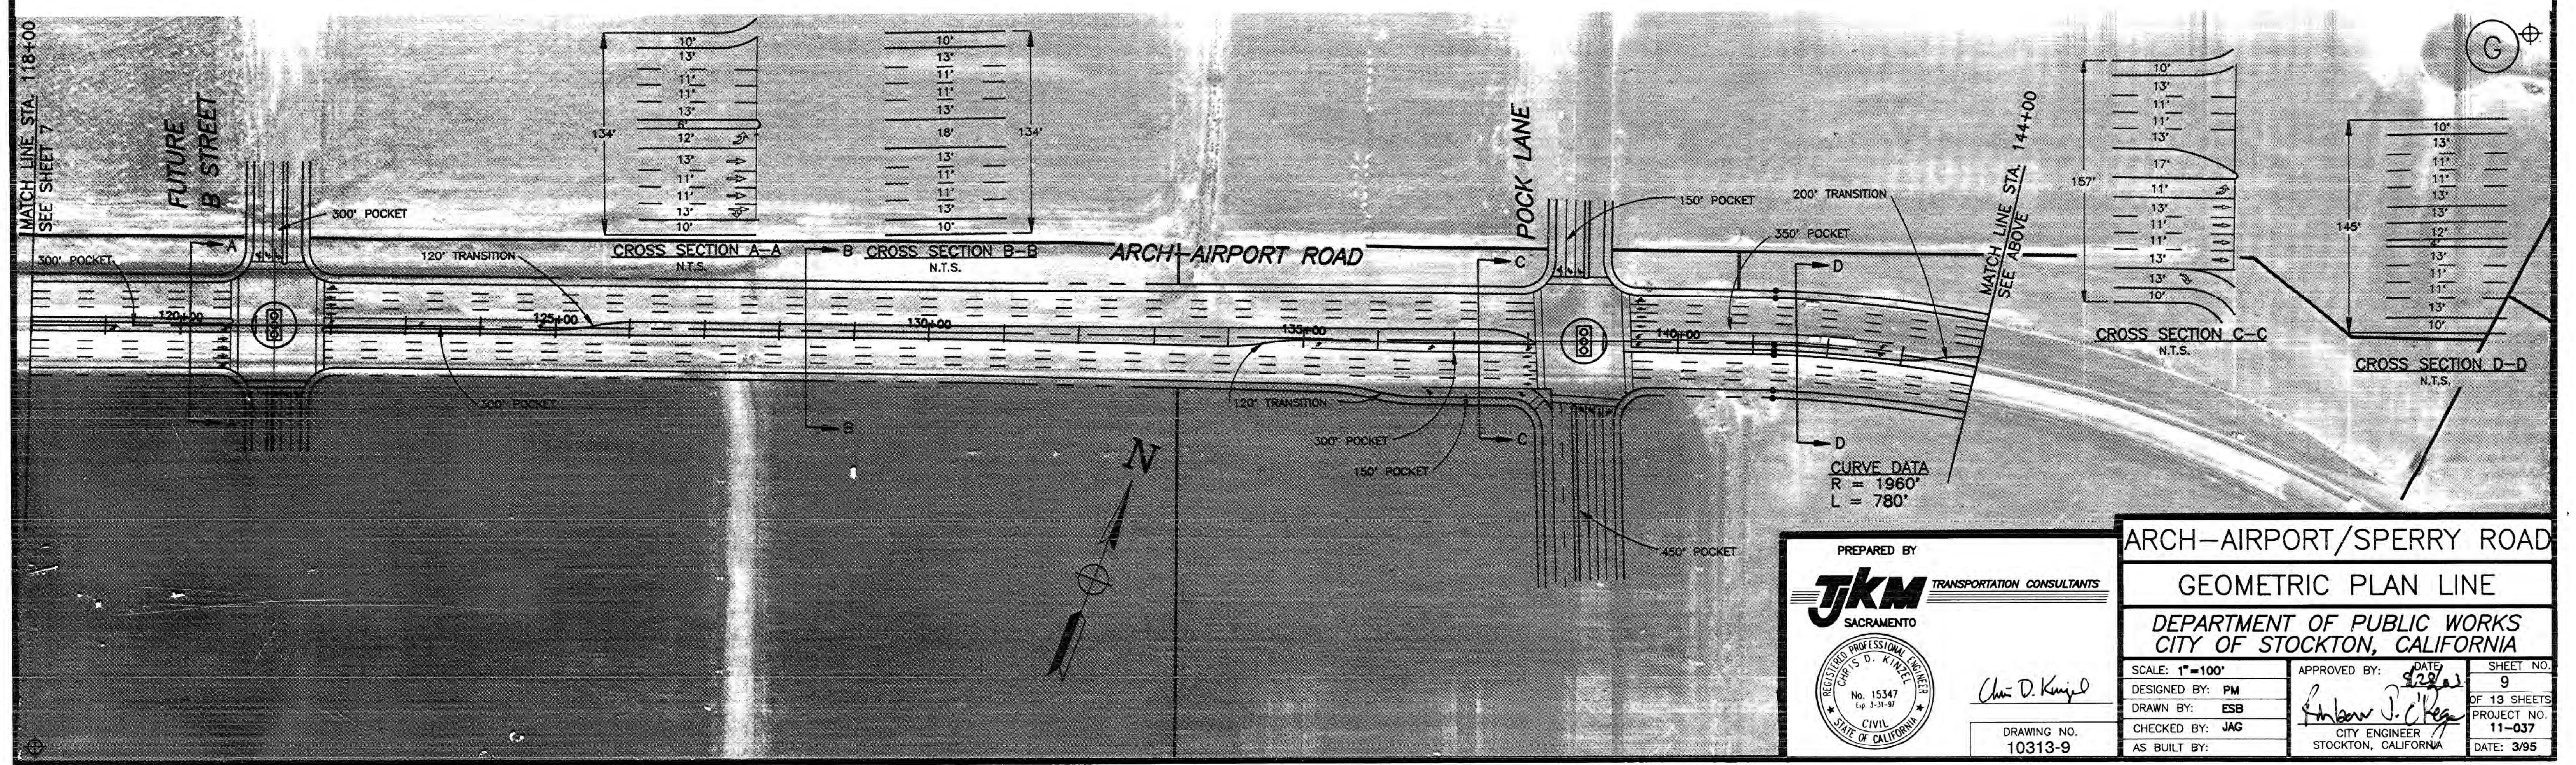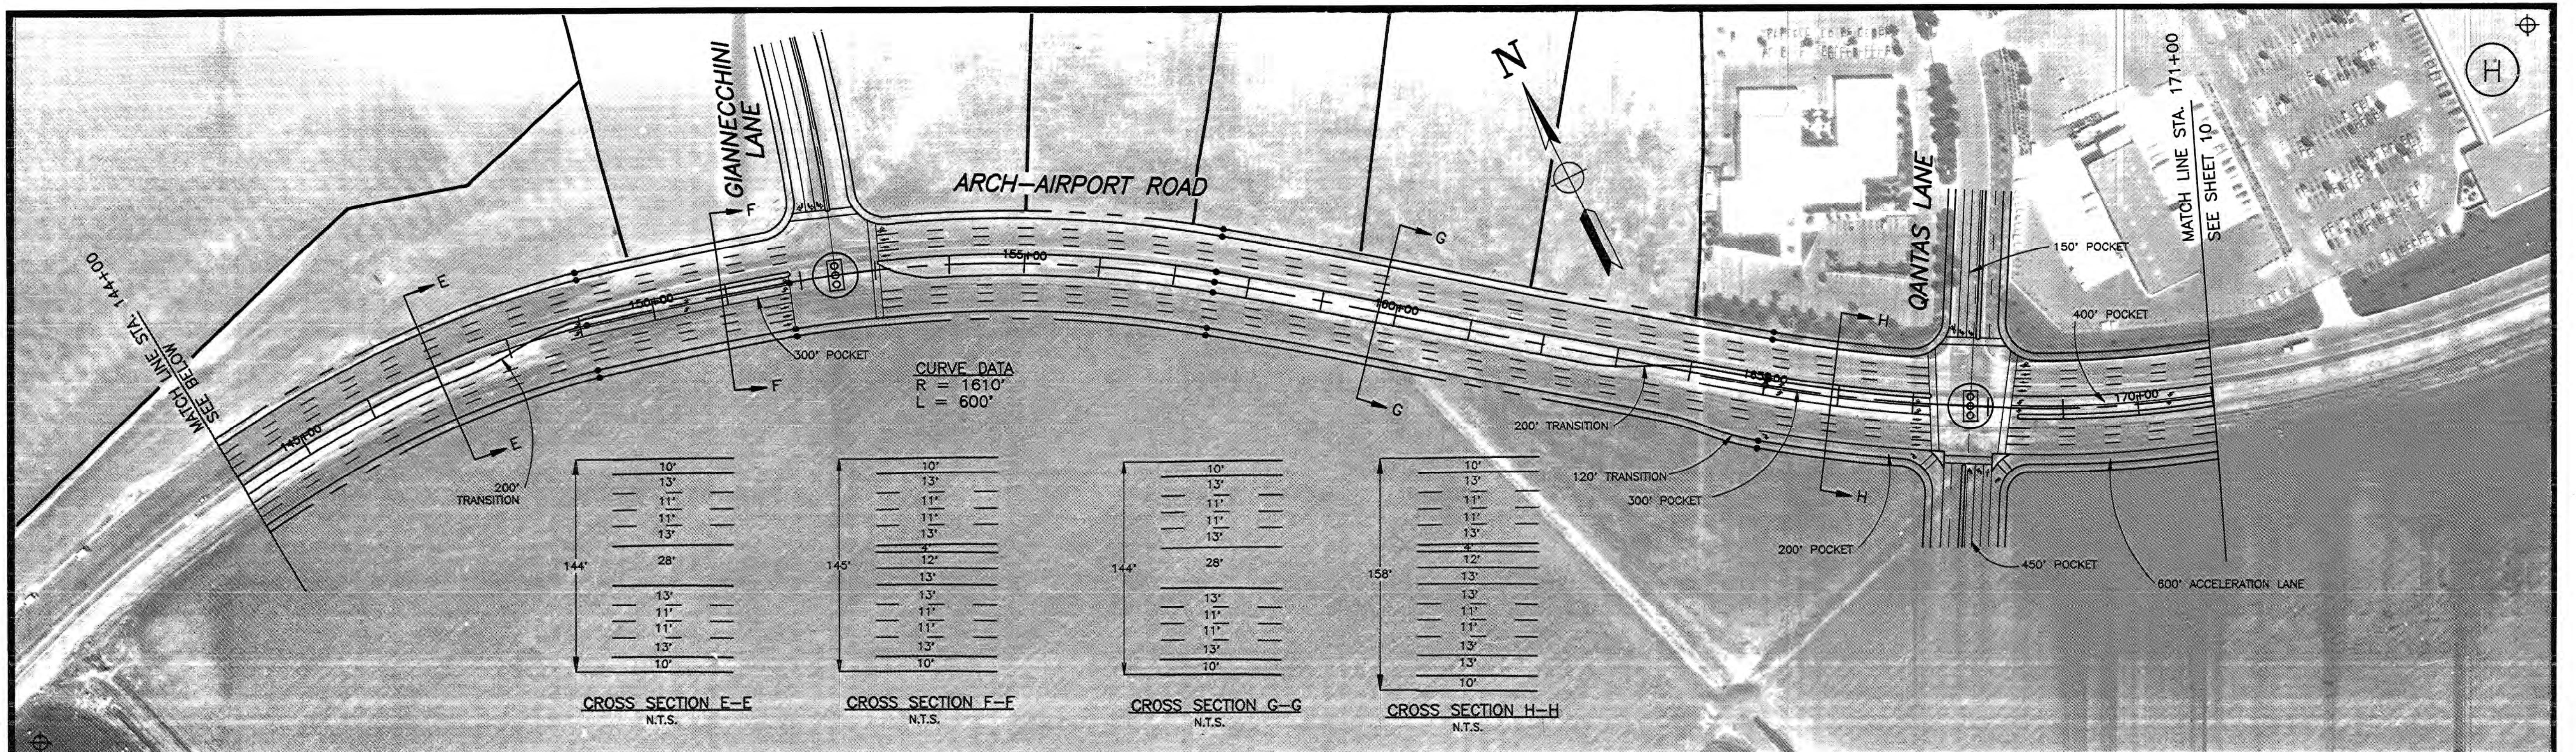

4604.8C

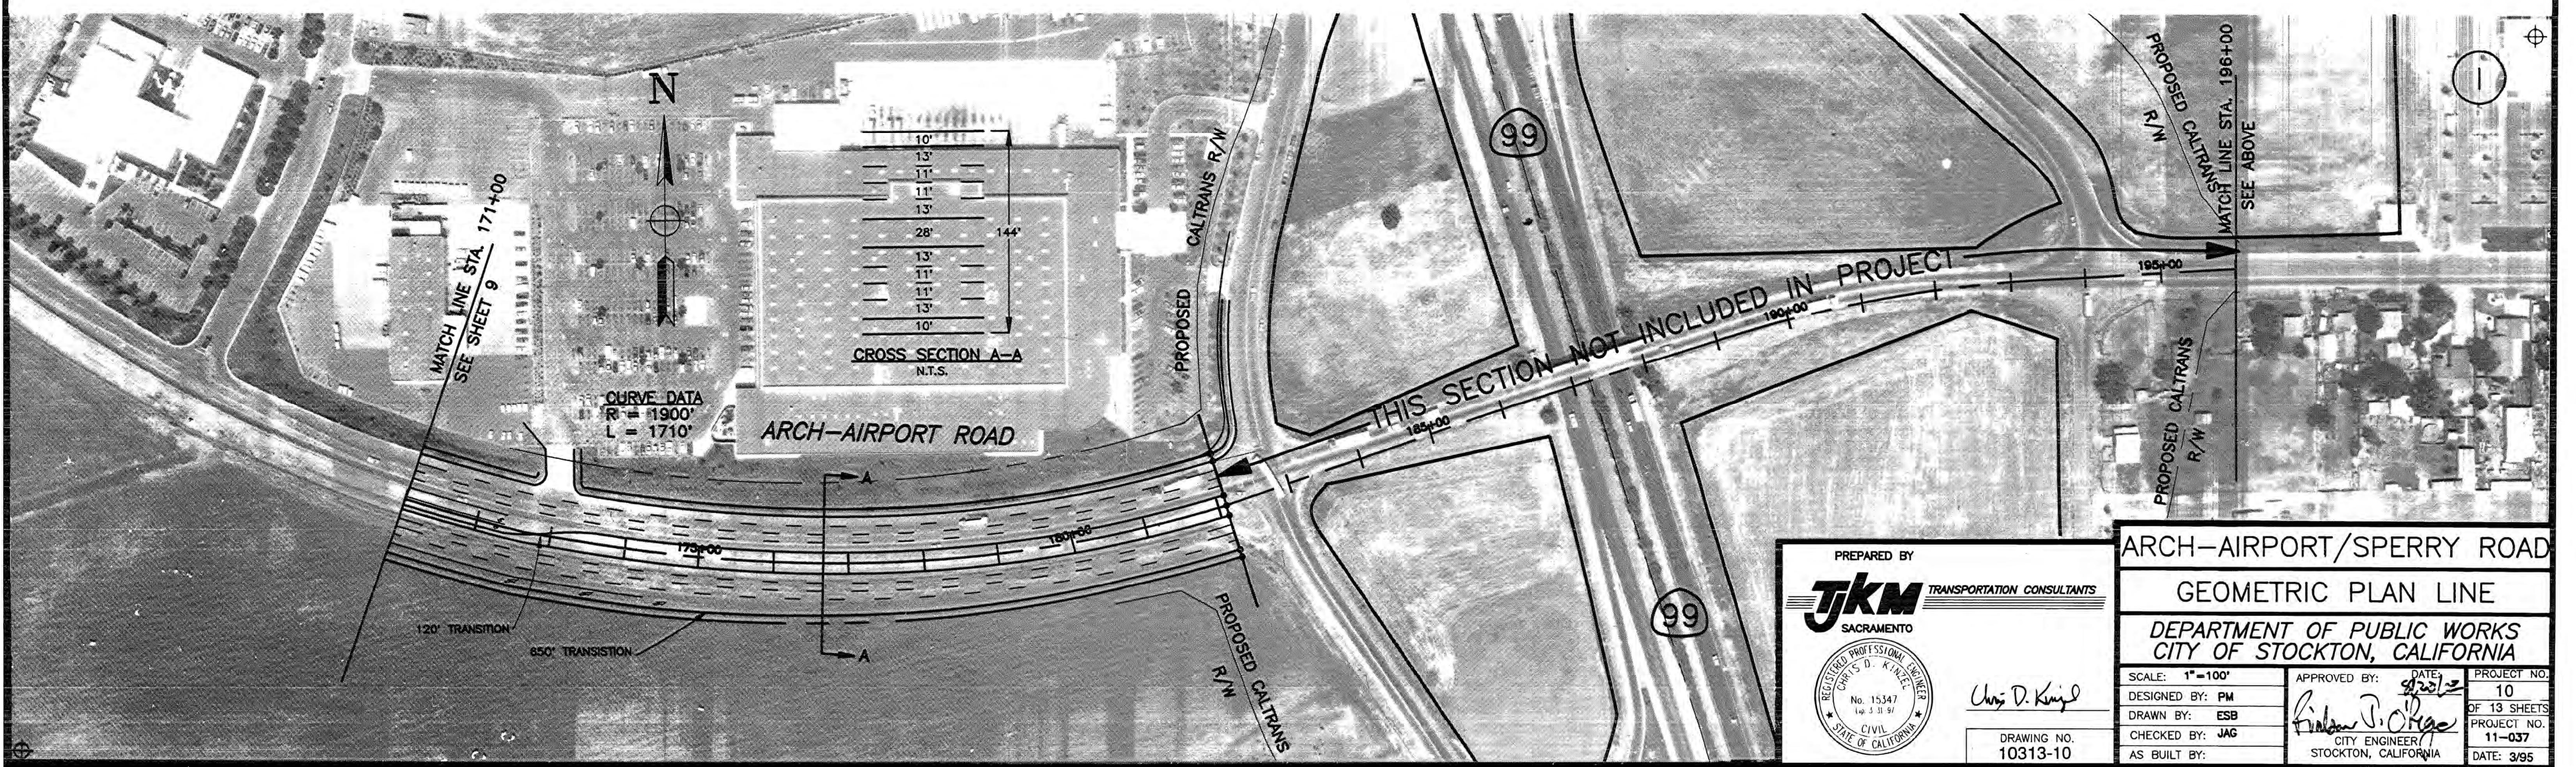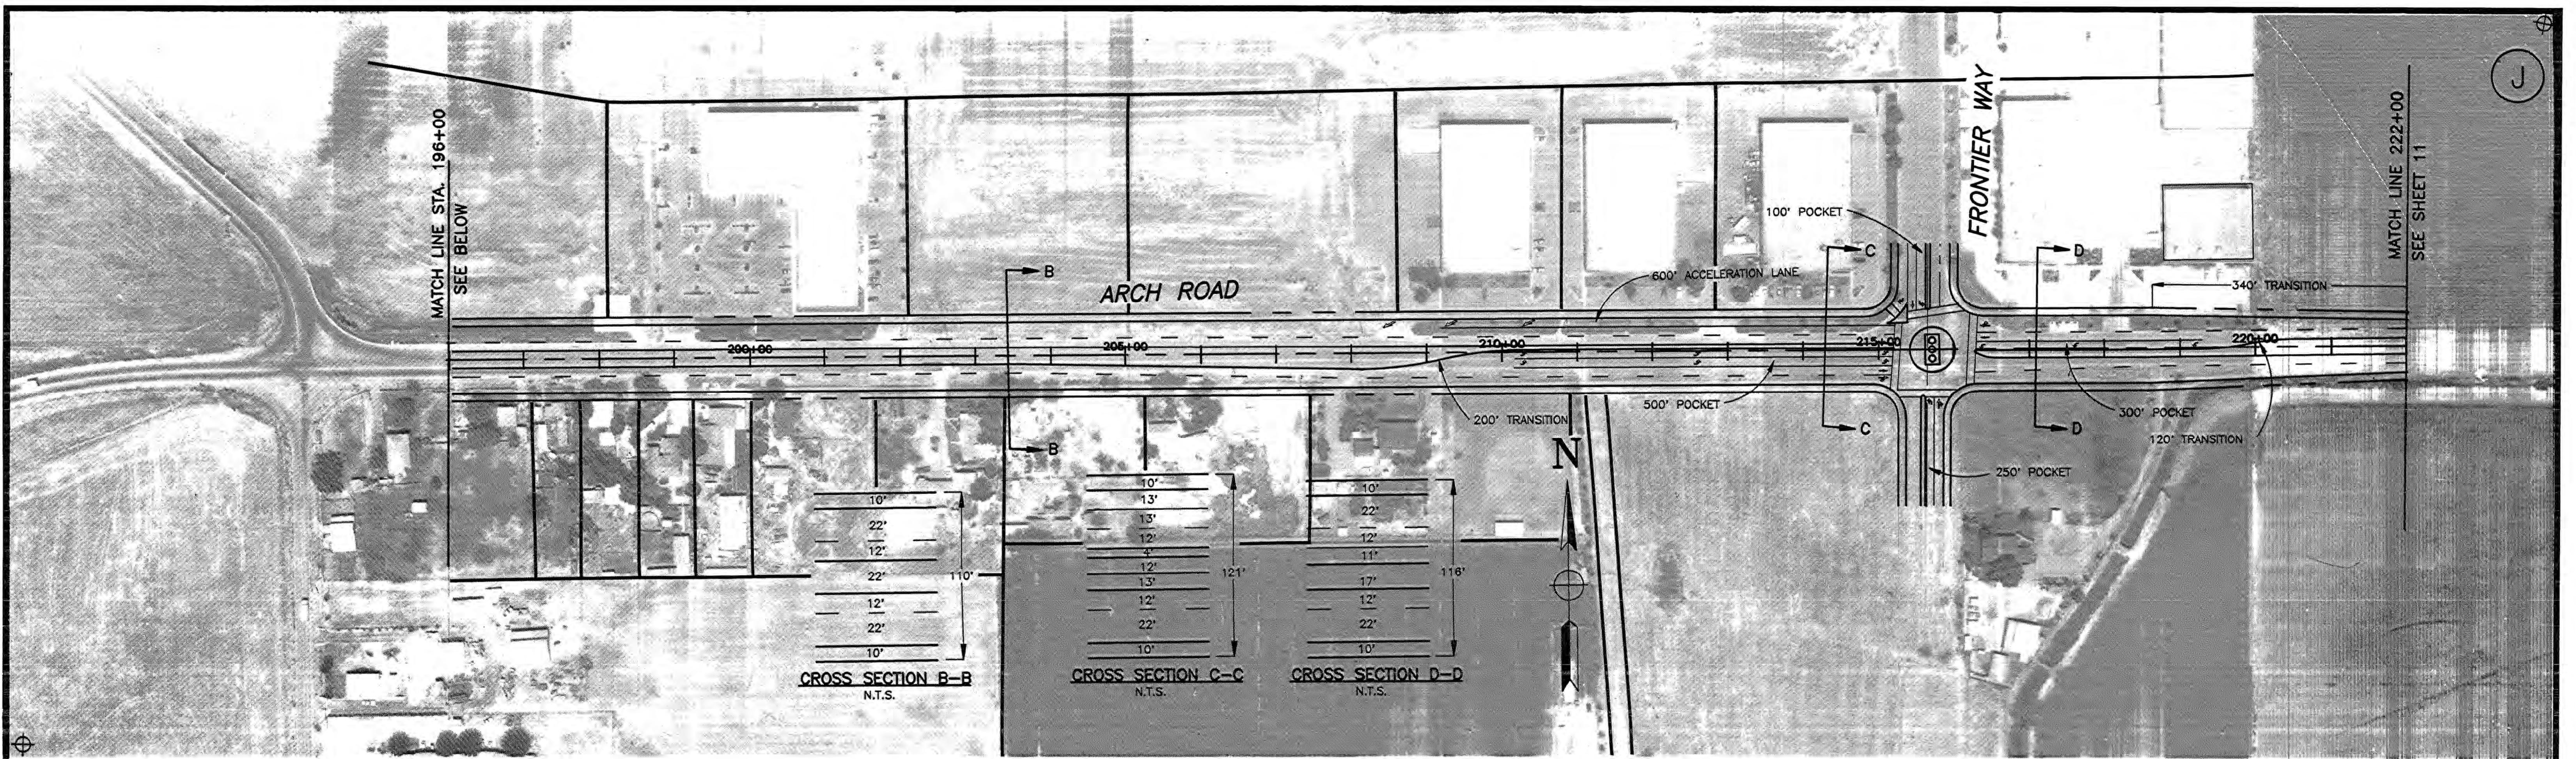

4604.9c

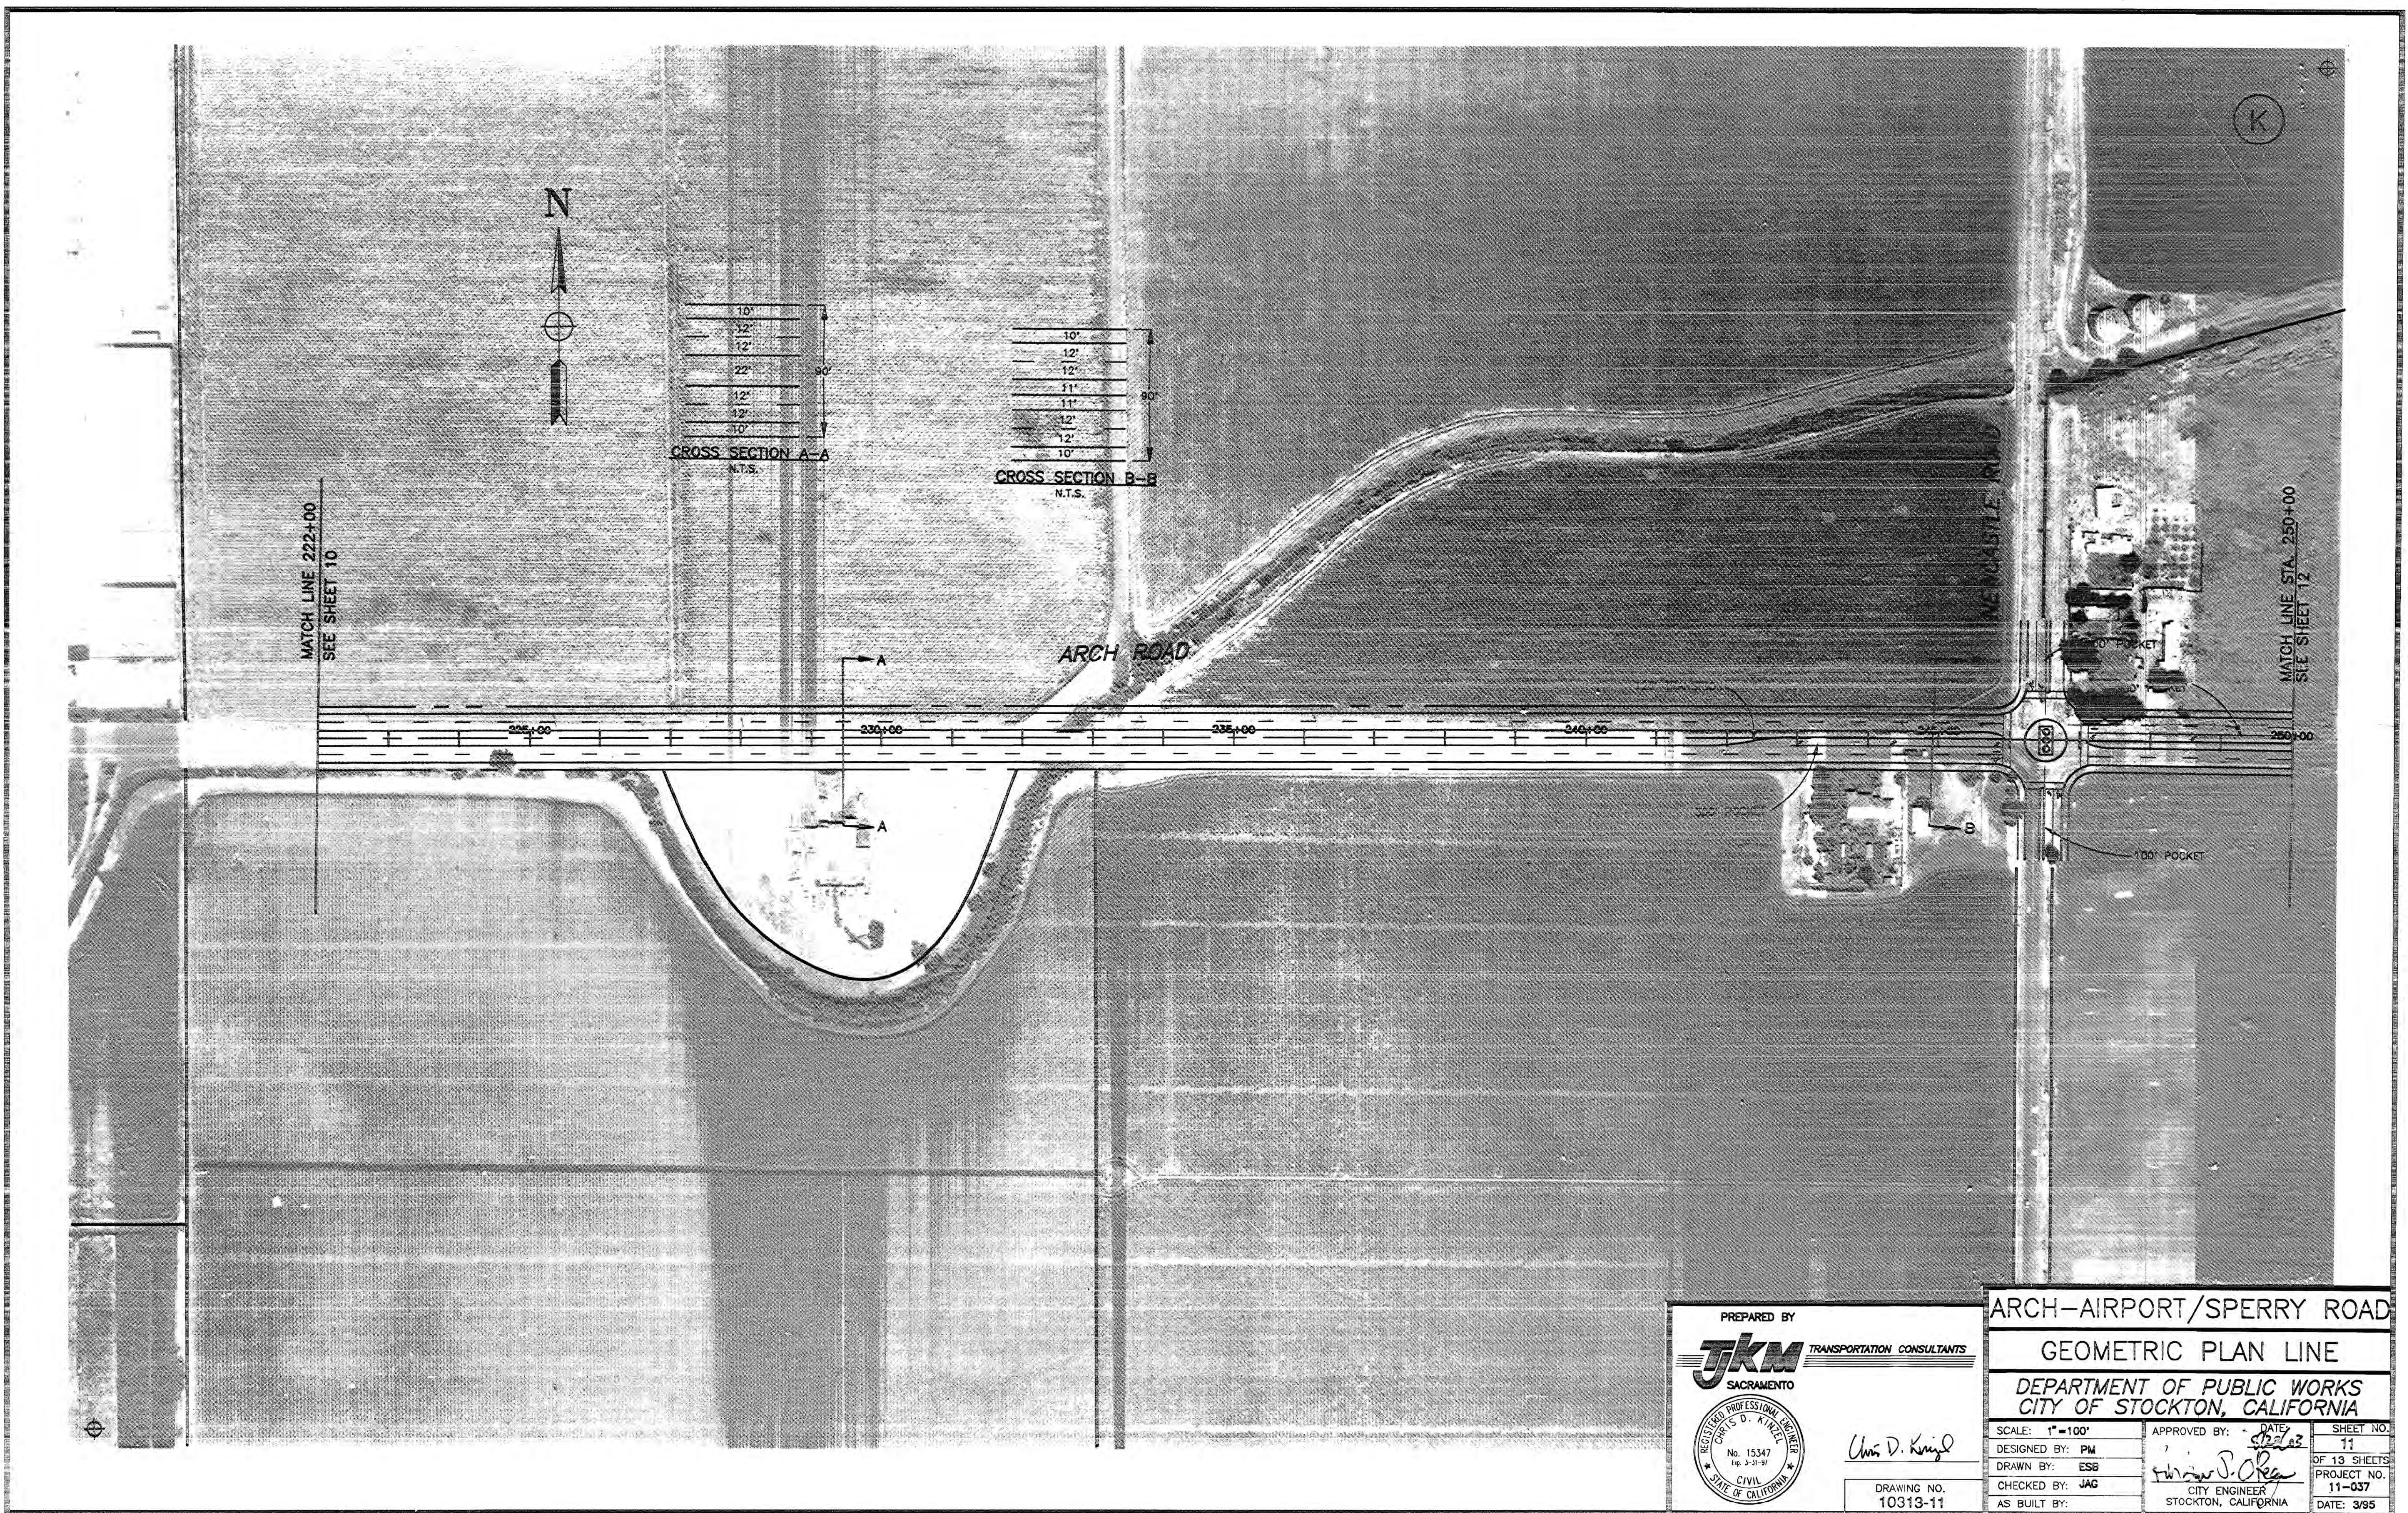


4604.10C



4604.11C

4604.12C
ARCH-AIRPORT/SPERRY ROAD
SPECIFIC ROAD PLAN
FROM INTERSTATE FIVE TO AUSTIN ROAD
GEOMETRIC PLAN LINE
TURN TRANSPORTATION CONSULTANTS
AUGUST 23, 2002

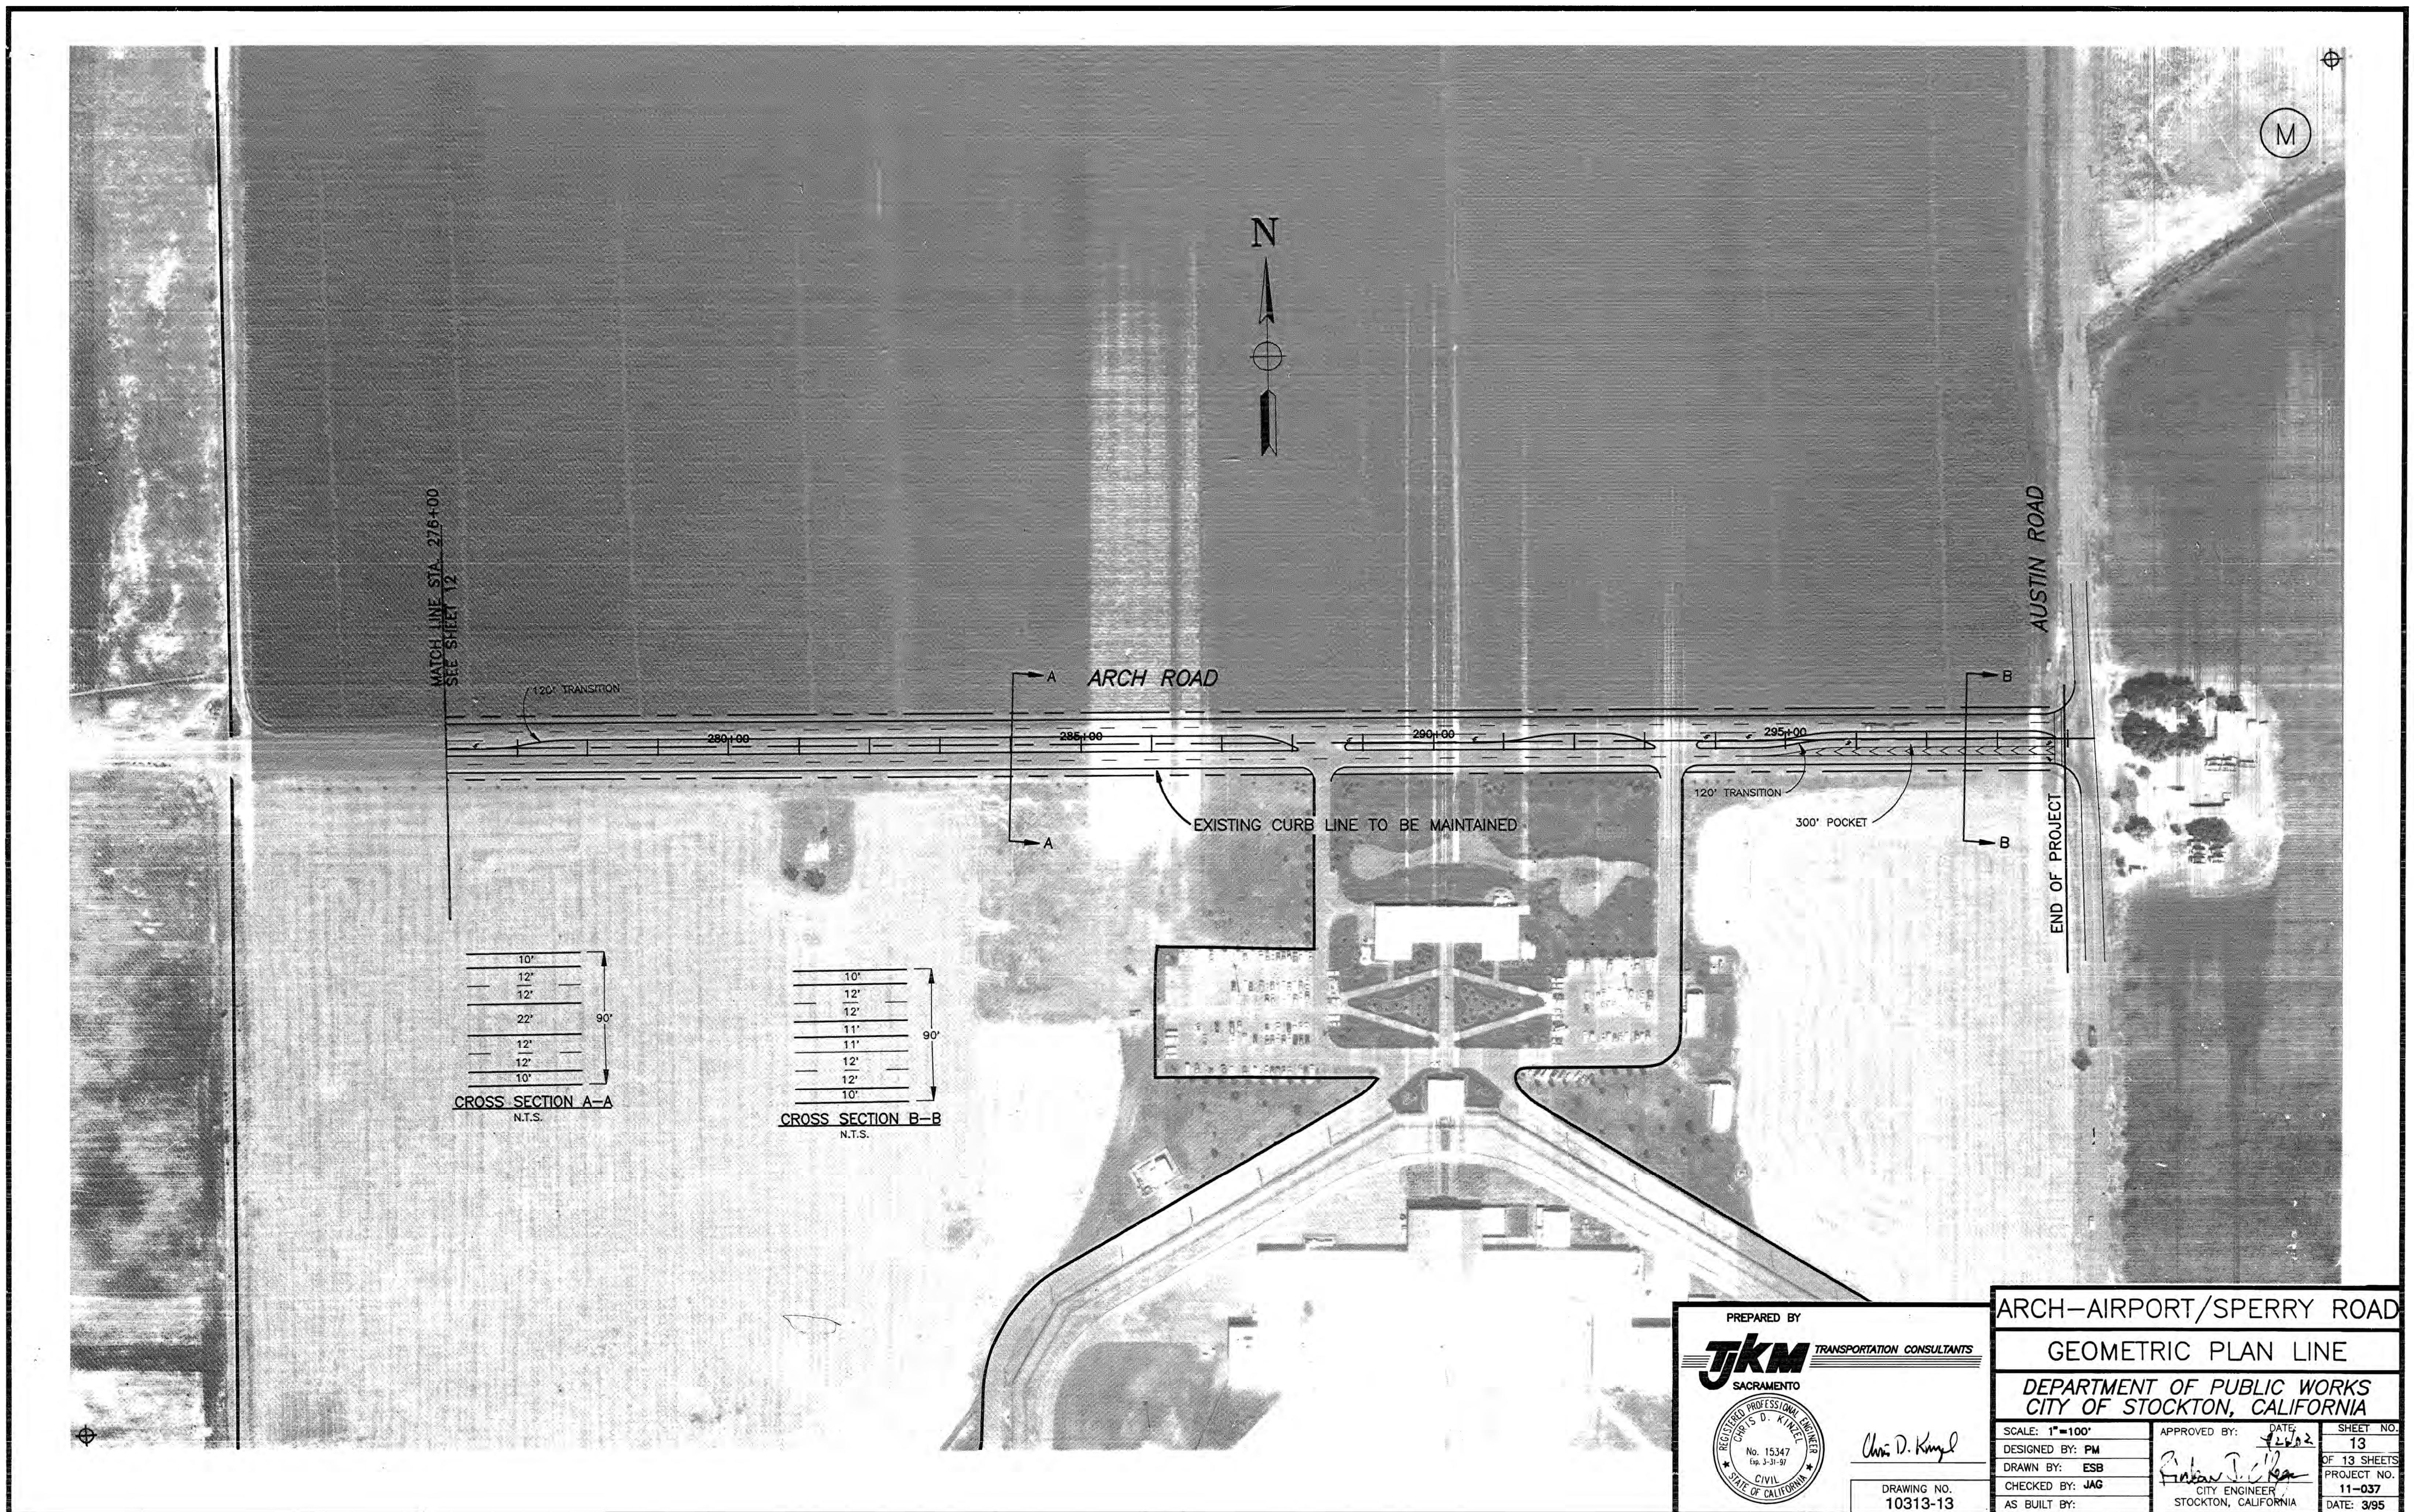

4604.12C